


T. 3 S., R. 2 E. W.M.

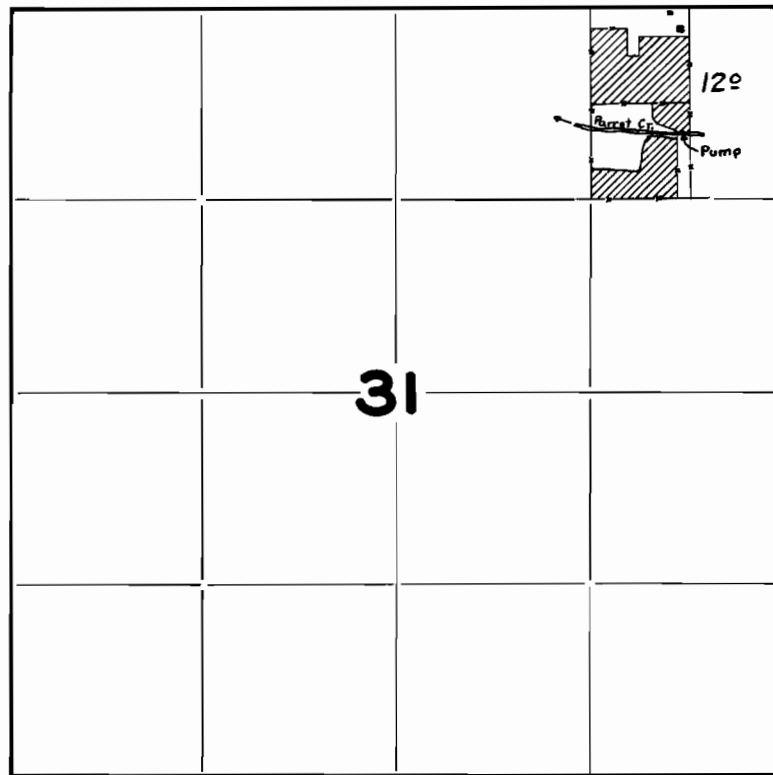

**FINAL PROOF SURVEY
UNDER**

Application No. 17472 Permit No. 13183

IN NAME OF

Alvin J. Phillips

Surveyed July 24 1942, by Geo. L. Anderson