


T. 15. R 3W.

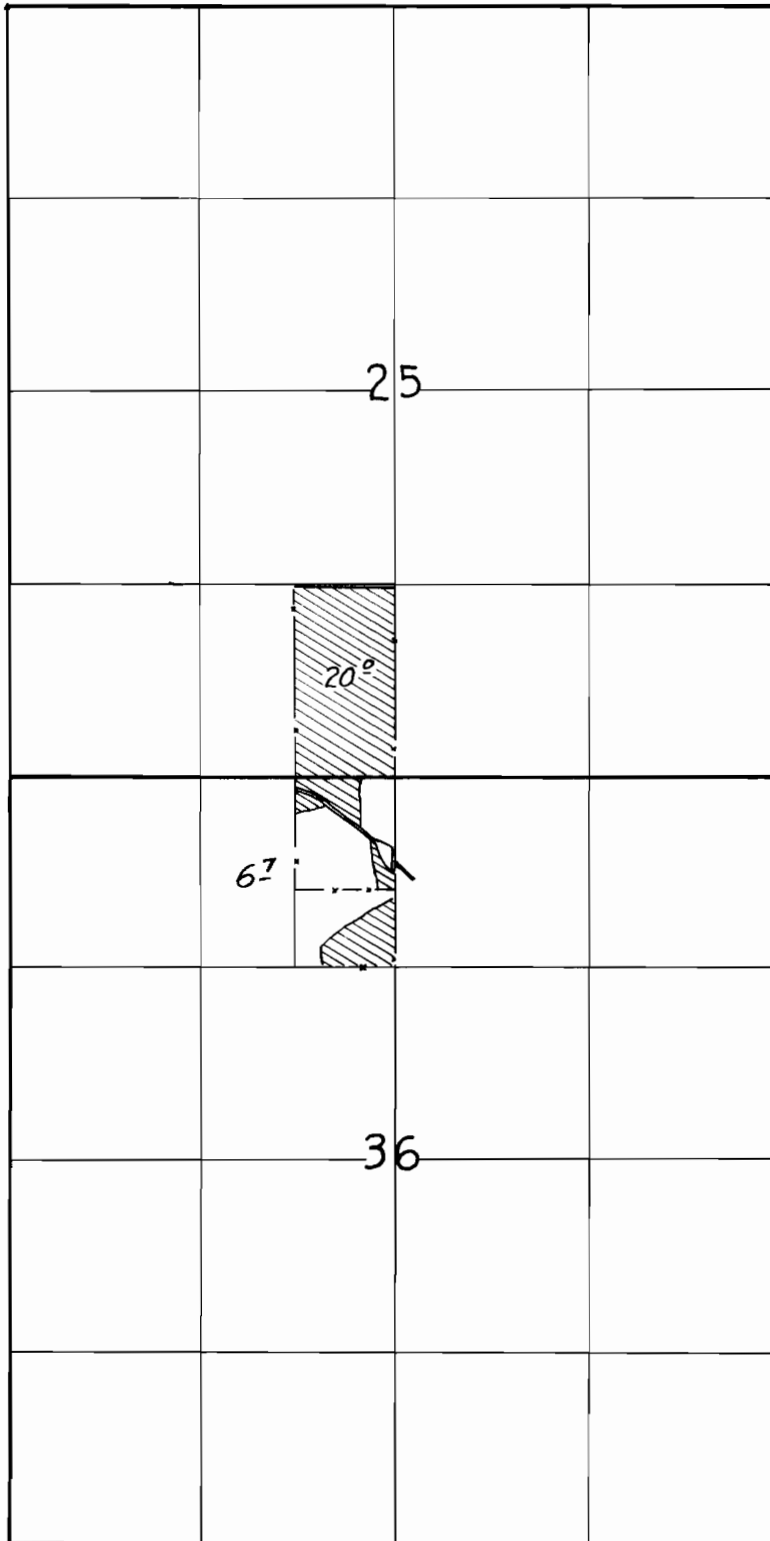

Surveyed Aug. 16, 1941

Chester A. Cummings

App. 17479

Permit 13189