


# T.12 S.. R. 6 W. W.M.

RECEIVED  
NOV 29 2002  
WATER RESOURCES DEPT  
SALEM, OREGON

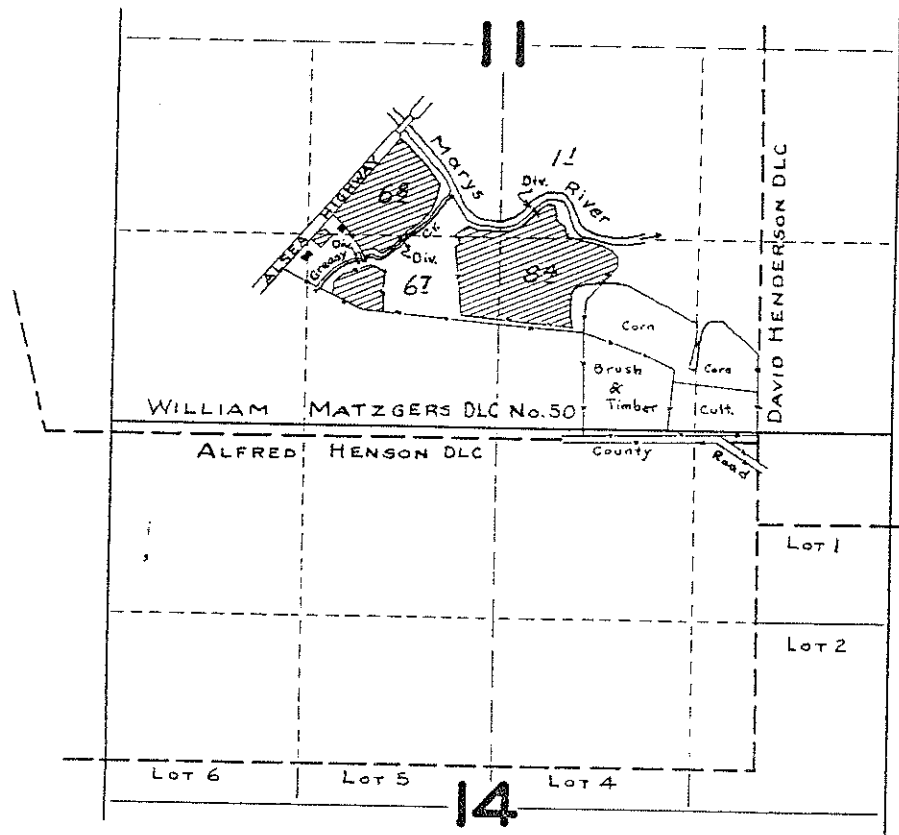

## FINAL PROOF SURVEY UNDER

Application No. 17502 Permit No. 13207

IN NAME OF

W.W. & Jessie Looney

Surveyed Sept. 2, 1942, by Geo. T. Adelman