


T. 3 S., R. 2 W. W.M.

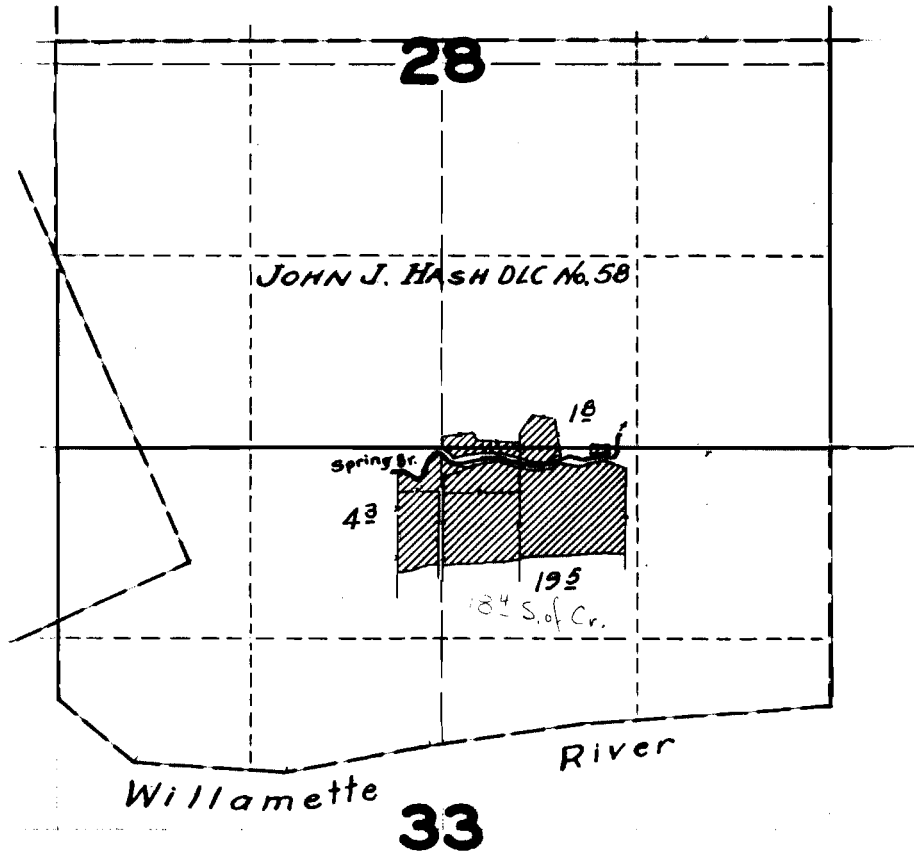

FINAL PROOF SURVEY
UNDER

Application No. 17504 Permit No. 13209

IN NAME OF

Daniel Wohlgemuth

Surveyed Aug. 13, 1942, by Geo. Maderman