


T. 1 N. ^{AND} 1 S., R. 10 W. W.M.

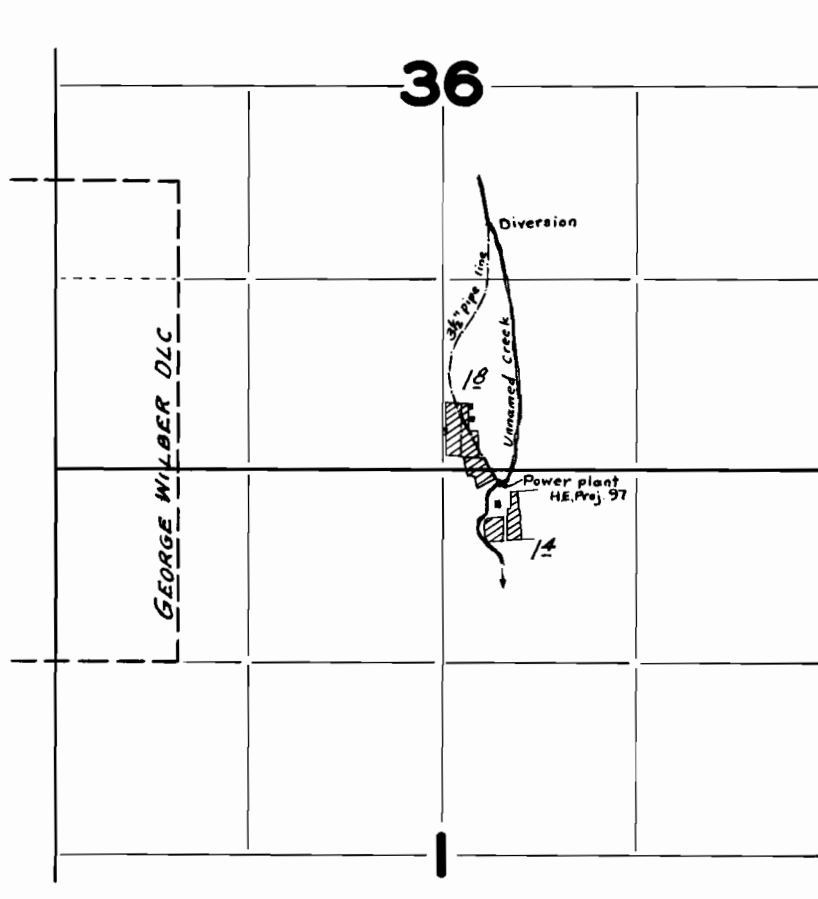

FINAL PROOF SURVEY
UNDER

Application No. 17507 Permit No. 13212

IN FAVOR OF

Mrs. A. N. Andruss

Surveyed Aug. 20 1942, by Geo. V. Madenman