


T. 5 S., R. 9 W. W.M.

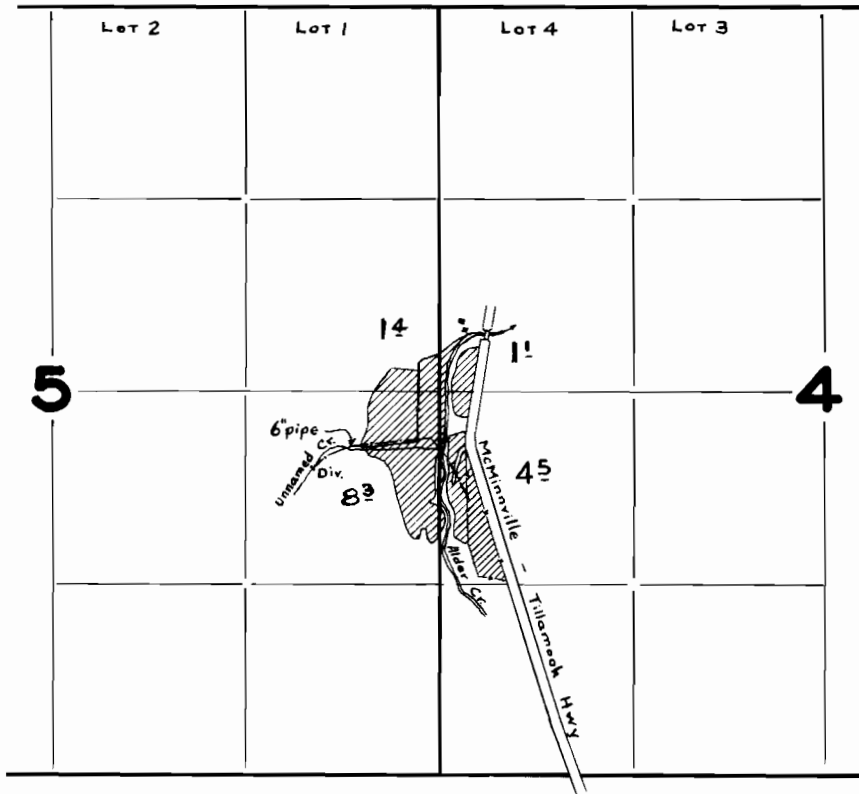

FINAL PROOF SURVEY
UNDER

Application No. 17527 Permit No. 13232

IN NAME OF

Elizabeth Erickson

Surveyed Aug. 21, 1942, by Geoff Maderman