


T. 6 S., R. 1 W. W.M.

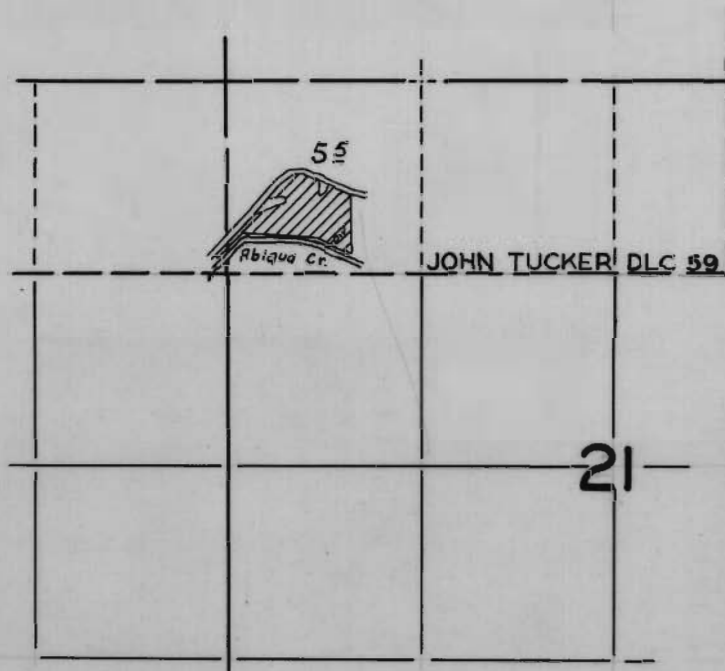

**FINAL PROOF SURVEY**  
UNDER

Application No. 17530 Permit No. 13235

IN NAME OF

C. W. Cross

Surveyed July 3, 1942, by Geo. J. Anderson