


T.12 S., R. 5 W. W.M.

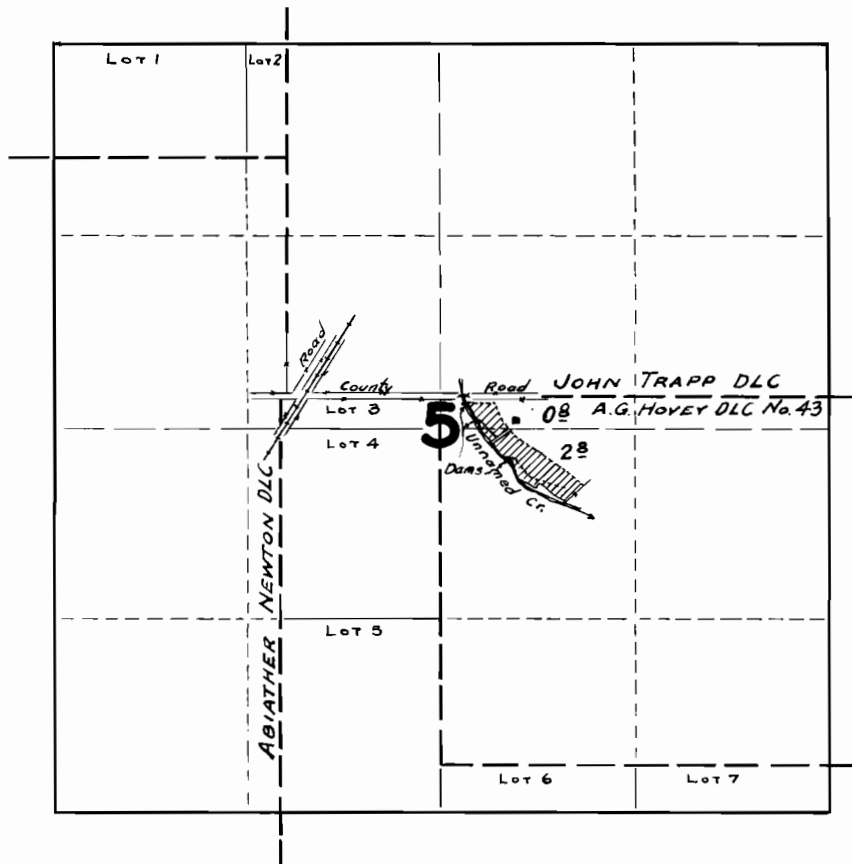

FINAL PROOF SURVEY UNDER

Application No. 17563 Permit No. 13264

IN NAME OF

Chas. & Myrtle Skillings

Surveyed Sept. 3, 1942, by Geo. Aderman