


T. 6 S. R. 3 W. W.M.

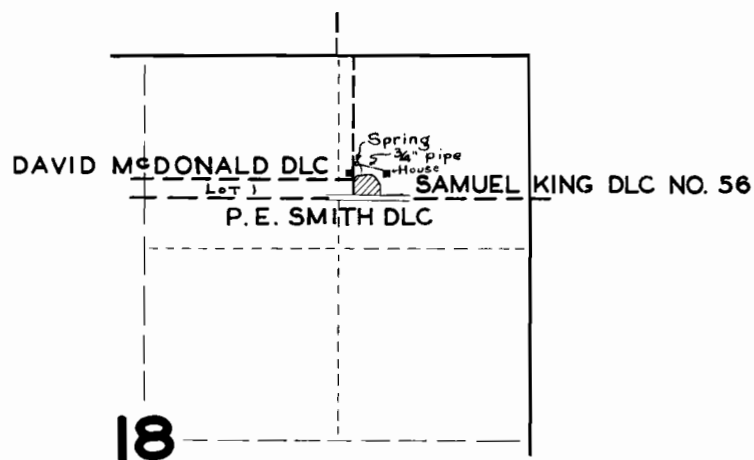

FINAL PROOF SURVEY
UNDER

Application No. 17581 Permit No. 13270

IN FAVOR OF

Theodore Daum

Surveyed June 2 1942, by Geo. Maderman