


T.15 S., R.3 <sup>AND</sup> 4 W. W.M.

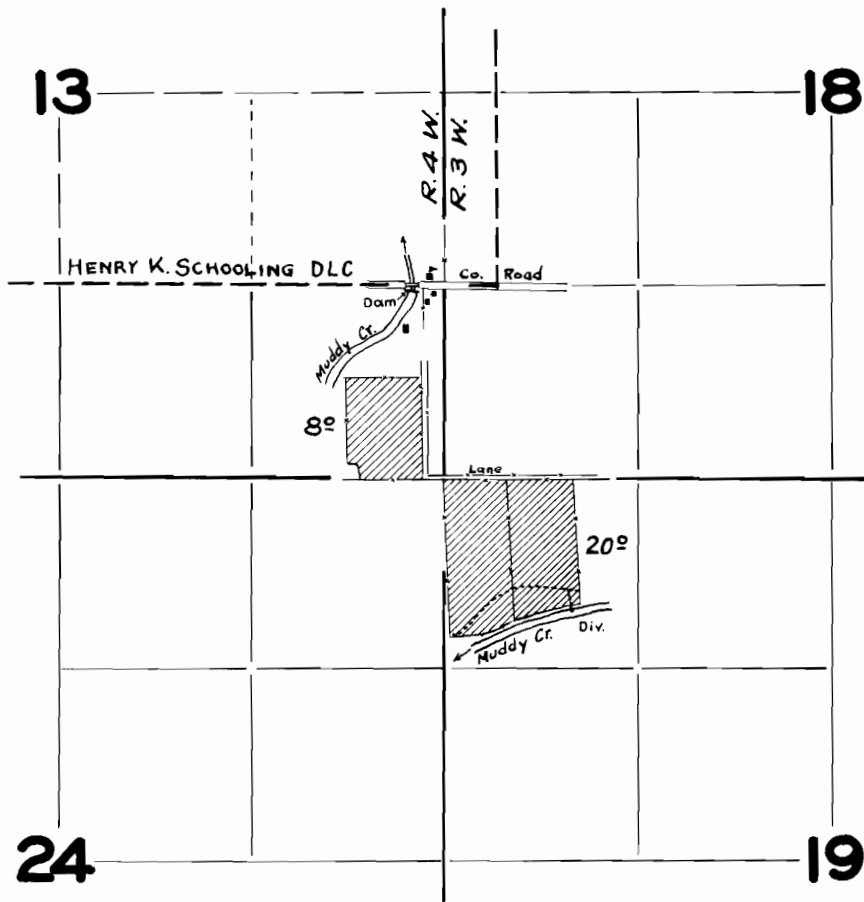

FINAL PROOF SURVEY  
UNDER

Application No. 17589 Permit No. 13285

IN NAME OF

Earl H. Baker

Surveyed Sept. 3, 1942, by Geo. W. Pederman