


T. 2 S., R. 2 E. W.M.

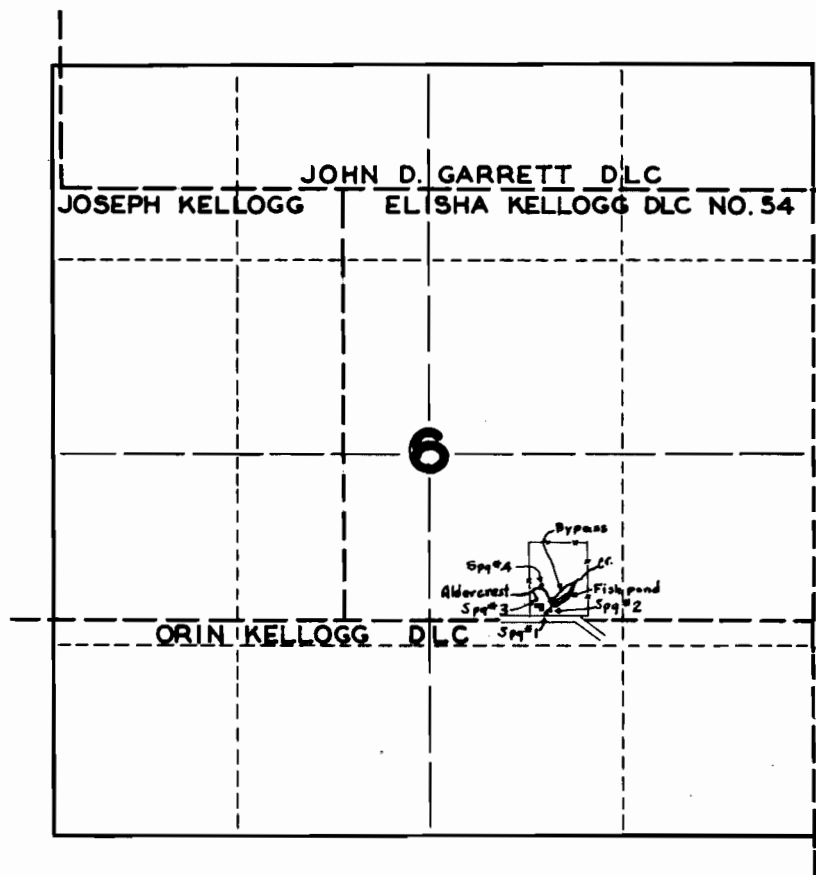

FINAL PROOF SURVEY
UNDER

Application No. 17621 Permit No. 13315

IN FAVOR OF

James P. Haworth

Surveyed July 28, 1942, by Geoff Maderman