


T. 1 S., R. 4 W. W.M.

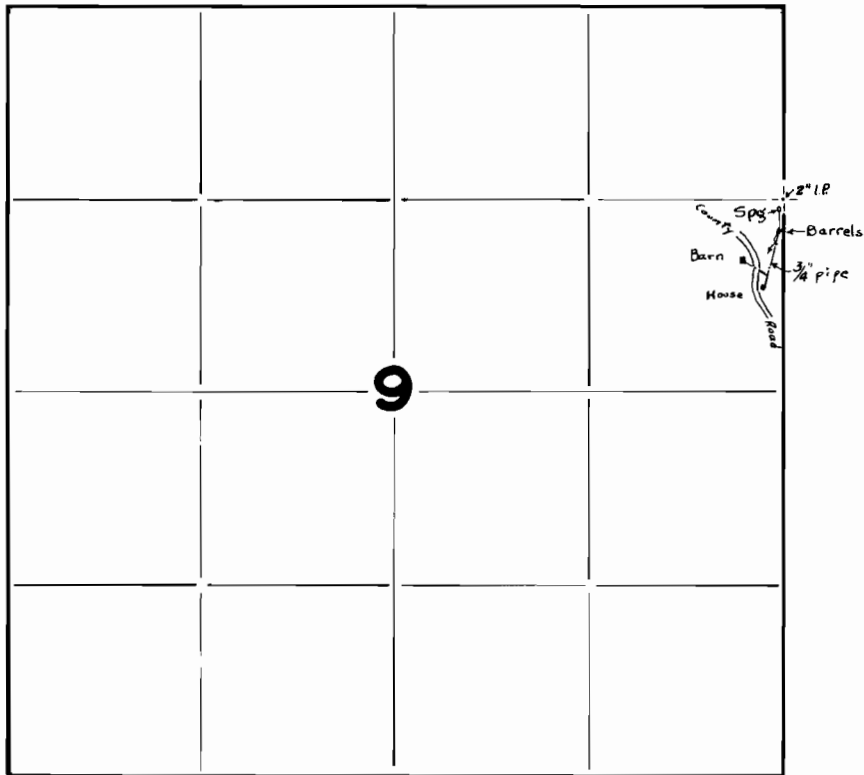

FINAL PROOF SURVEY UNDER

Application No. 17476 Permit No. 13321

IN NAME OF

E. F. Herr

Surveyed Aug 11 1942, by Geo. Maderman