


TOWNSHIP 4 SOUTH. RANGE 2 WEST W.M.

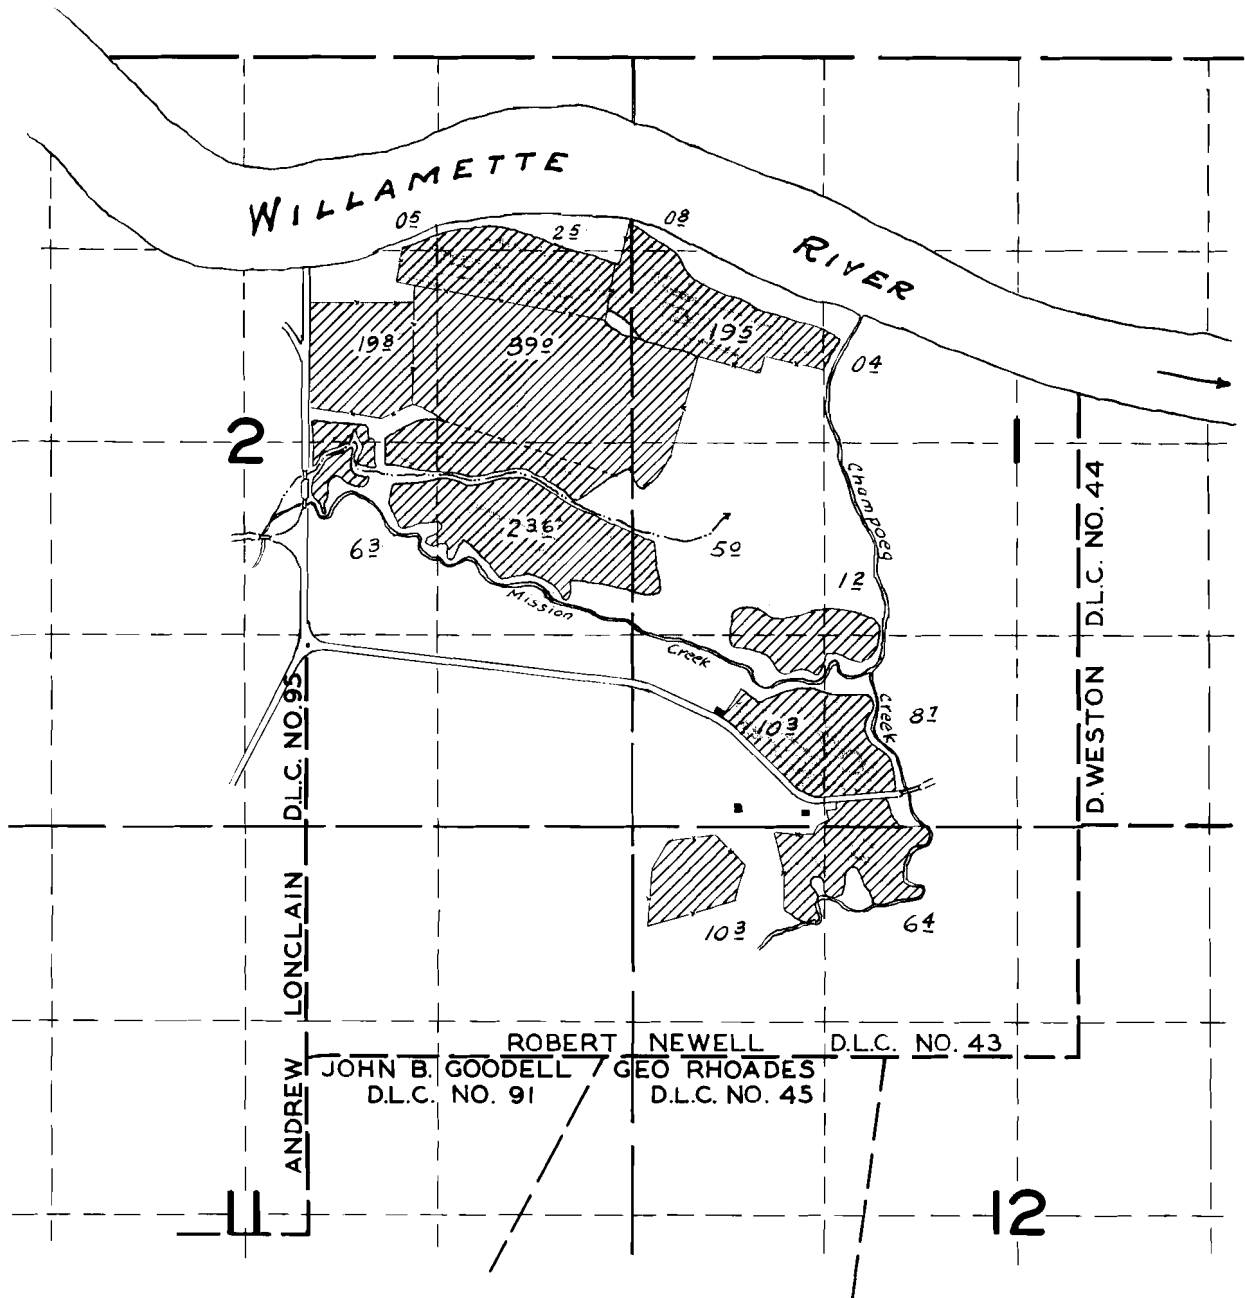

FINAL PROOF SURVEY

UNDER

Application No. 16600 / 17661      Permit No. 12384 / 13355

IN NAME OF

*Henry Zorn*

Surveyed *June 22, 1942*, by *Geo. Maderman*