


**T. 3 S., R. 8 W. W.M.**

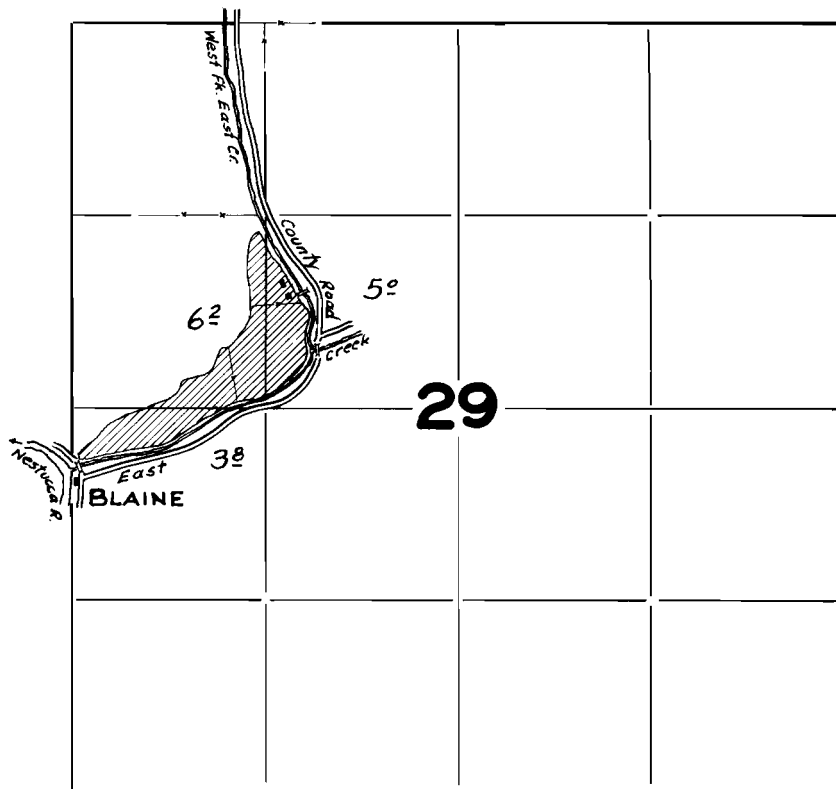

**FINAL PROOF SURVEY**

UNDER

Application No. 17678 Permit No. 13369

IN FAVOR OF

Alfred B. Jones

Surveyed Aug. 21, 1942, by Geol. Naderman