


T. 6 S..R. | W. W.M.

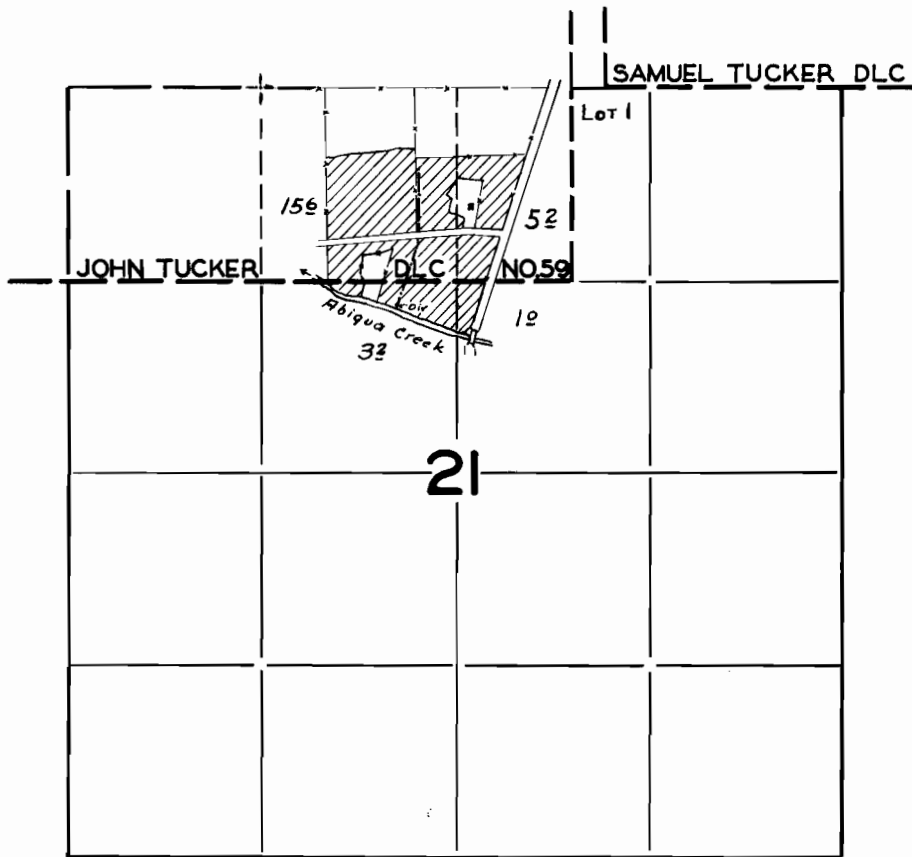

FINAL PROOF SURVEY UNDER

Application No. 17727 Permit No. 13395

IN NAME OF

W^m H. Schwarz

Surveyed July 3, 1942, by Geo. Mademan