


T. 2 S., R. 2 E. W.M.

SECTION 16

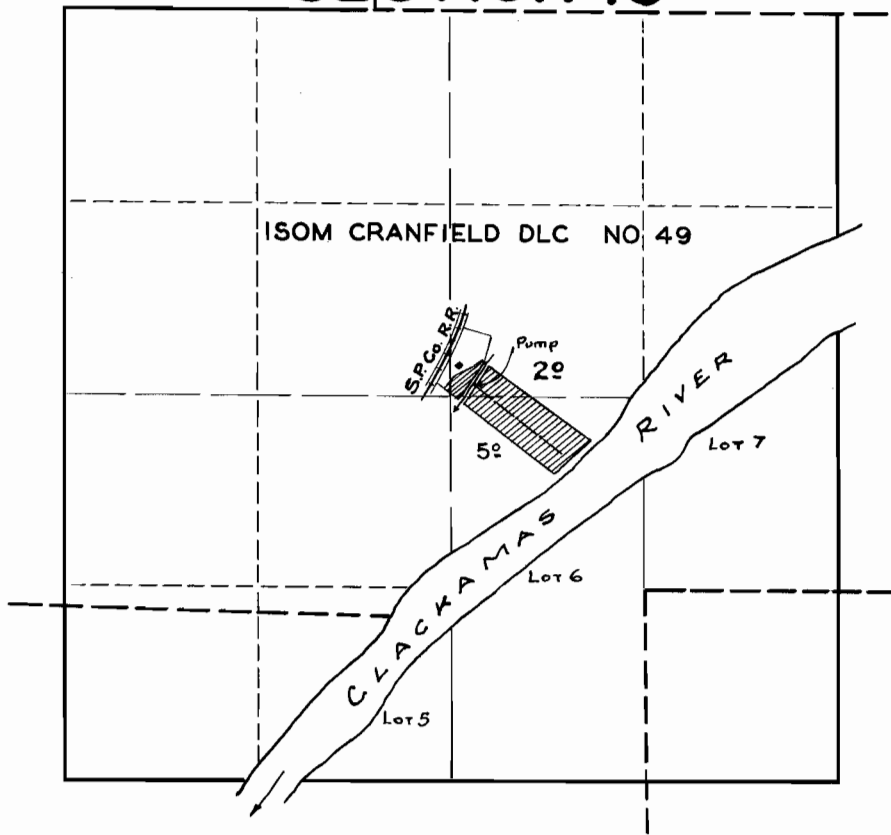

FINAL PROOF SURVEY
UNDER

Application No. 17725 Permit No. 13433

IN FAVOR OF

Albert M. Notz

Surveyed July 28, 1942. by Scott Anderson