


# T. 5 S., R. 2 E. W.M.

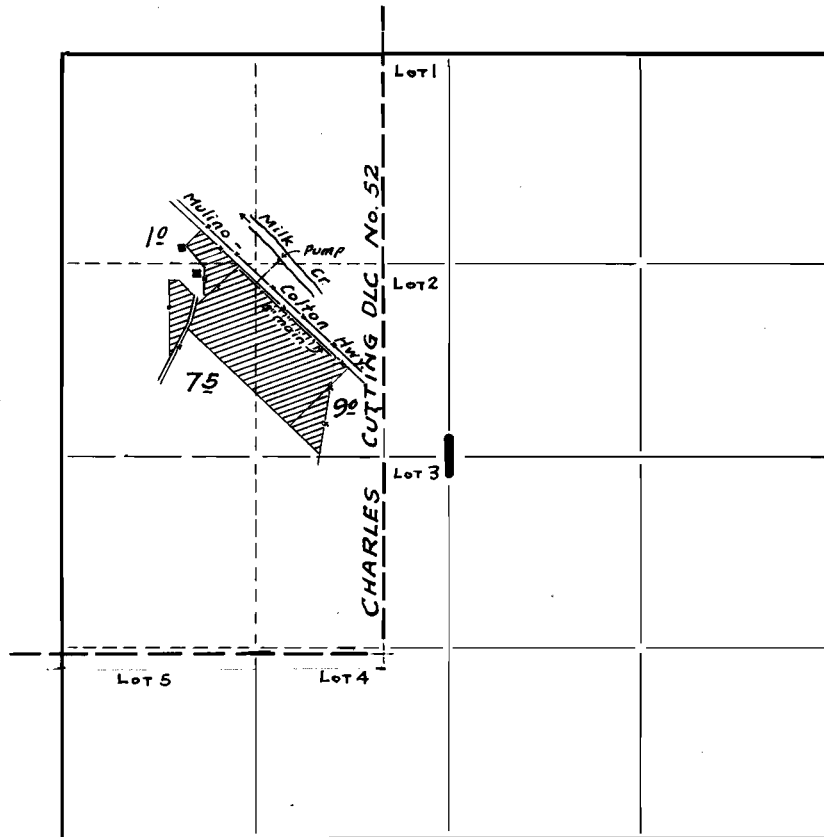

## FINAL PROOF SURVEY UNDER

Application No. 17761 Permit No. 13452

IN NAME OF

George Russell

Surveyed July 22 1942, by Geo. Mademan