


# T. 8 S., R. 4 W.W.M.

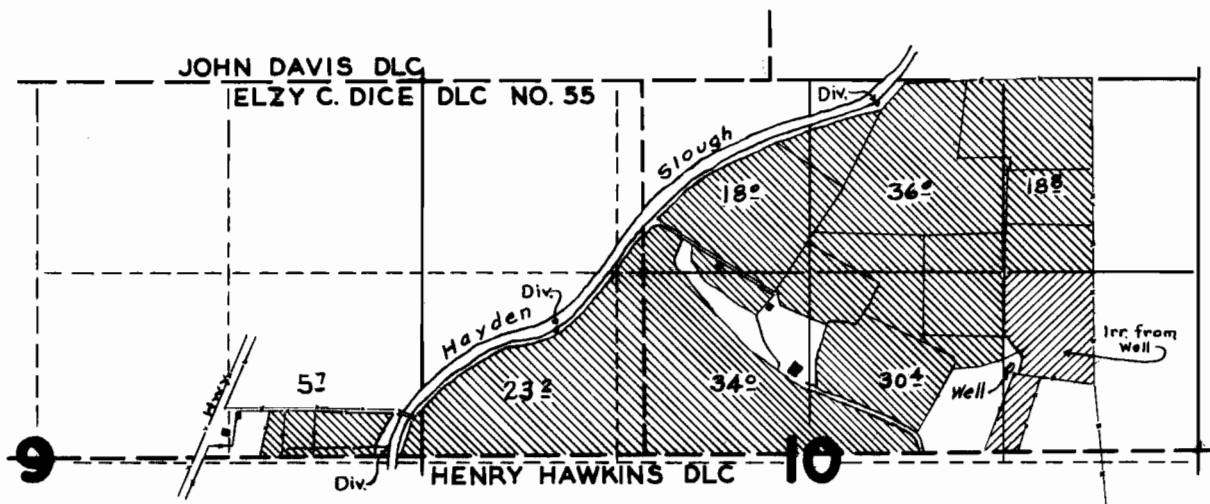

## FINAL PROOF SURVEY UNDER

Application No. 17809 Permit No. 13484

IN NAME OF

Pearl Ruddell

Surveyed June 11-12 1947, by Geo. Maderman