


T. 5 S., R. 1 E. W.M.

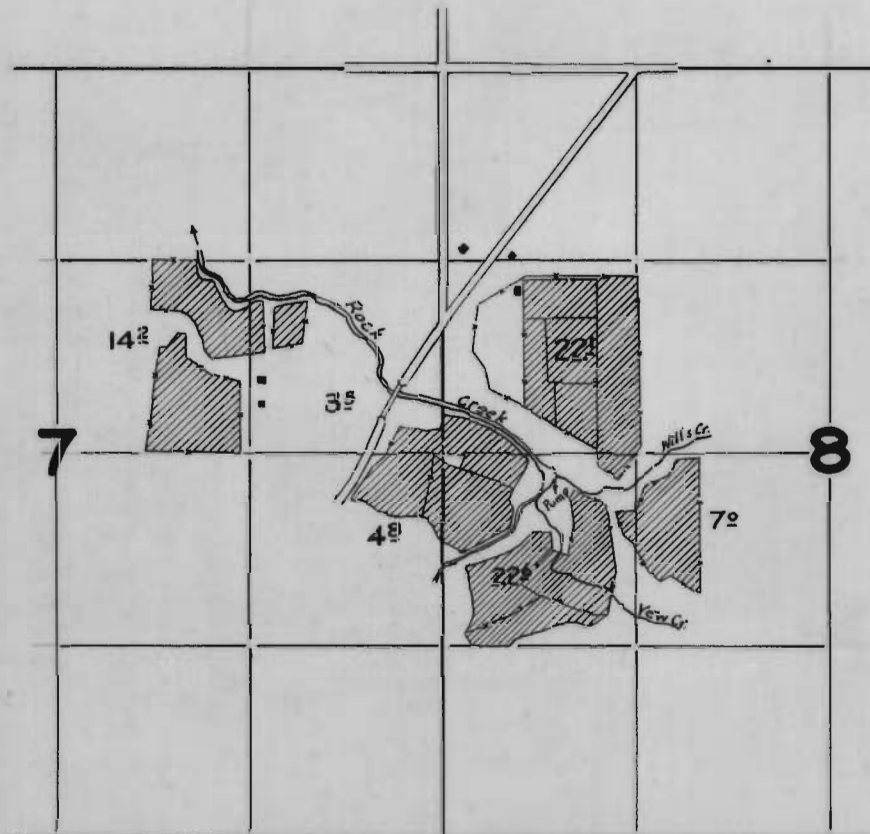

FINAL PROOF SURVEY
UNDER

Application No. 17810 Permit No. 13485

IN NAME OF

Harold M. Magnussen

Surveyed July 20 1942, by *Geol. Maderman*