


# T. 9 S., R. 1 W. W.M.

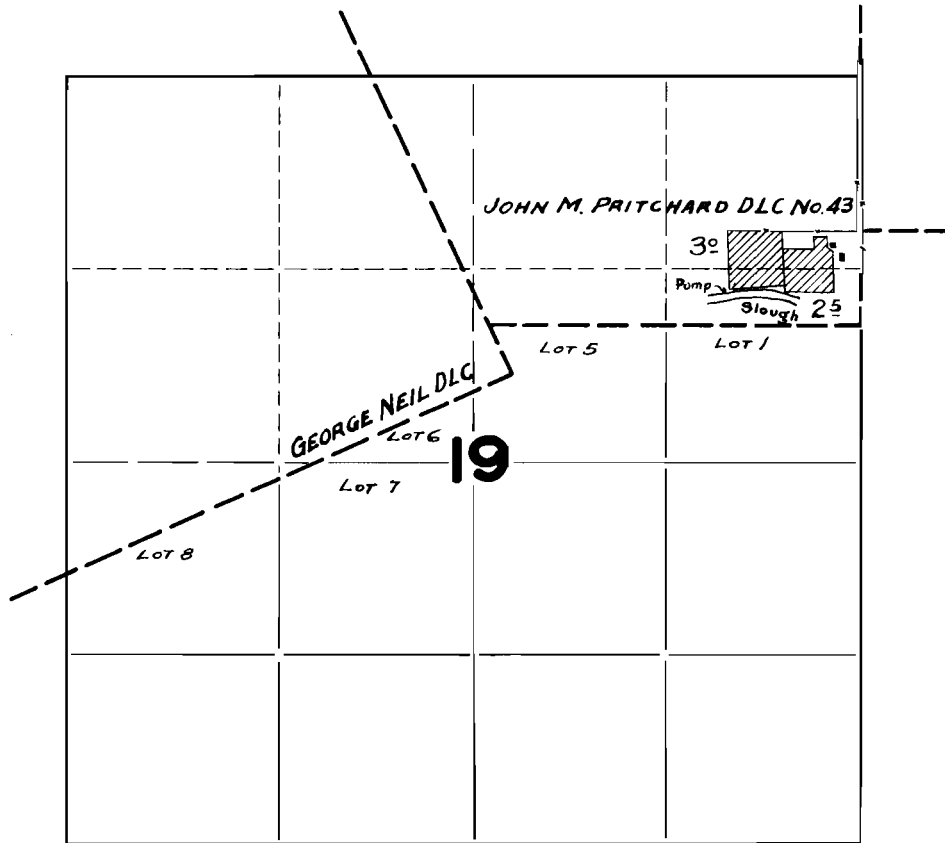

## FINAL PROOF SURVEY UNDER

Application No. 17826 Permit No. 13495

IN FAVOR OF

Theodore Diekman

Surveyed July 9, 1942, by Geo. V. Anderson