


T.10 S., R. 2 W. W.M.

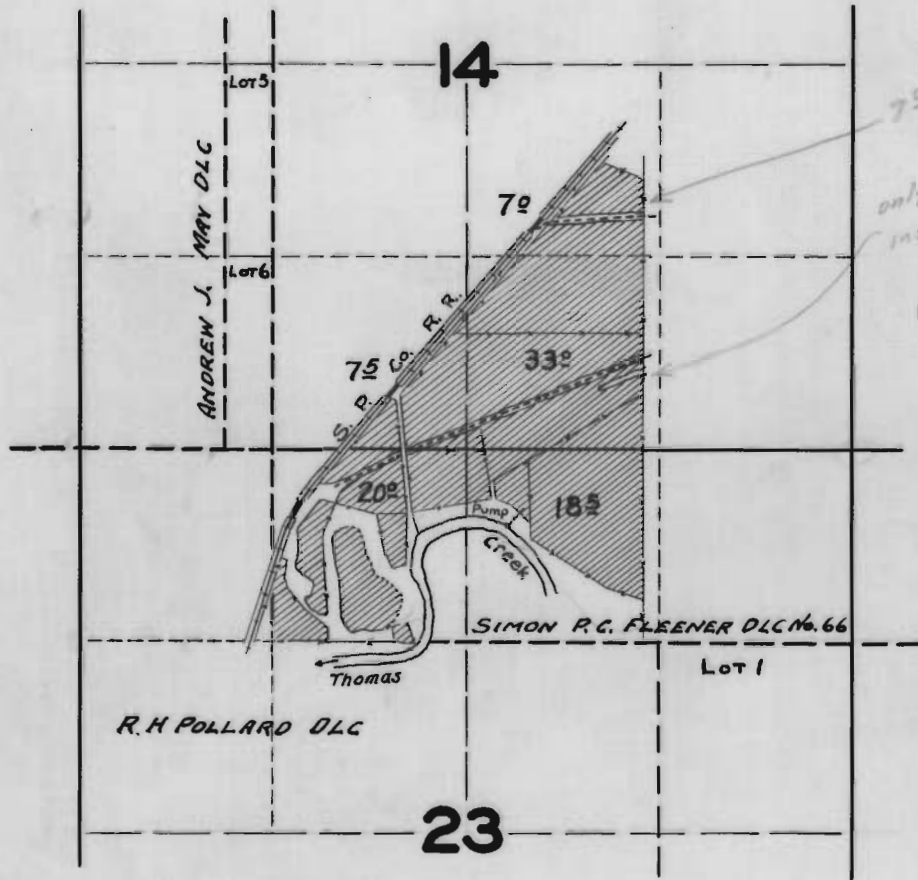

FINAL PROOF SURVEY UNDER

Application No. 17753 Permit No. 13502

IN NAME OF

Ben Gooch

Surveyed Sept. 15 1942, by Leol Maderman