


T.13 S., R. 1 W. W.M.

SECTION 24

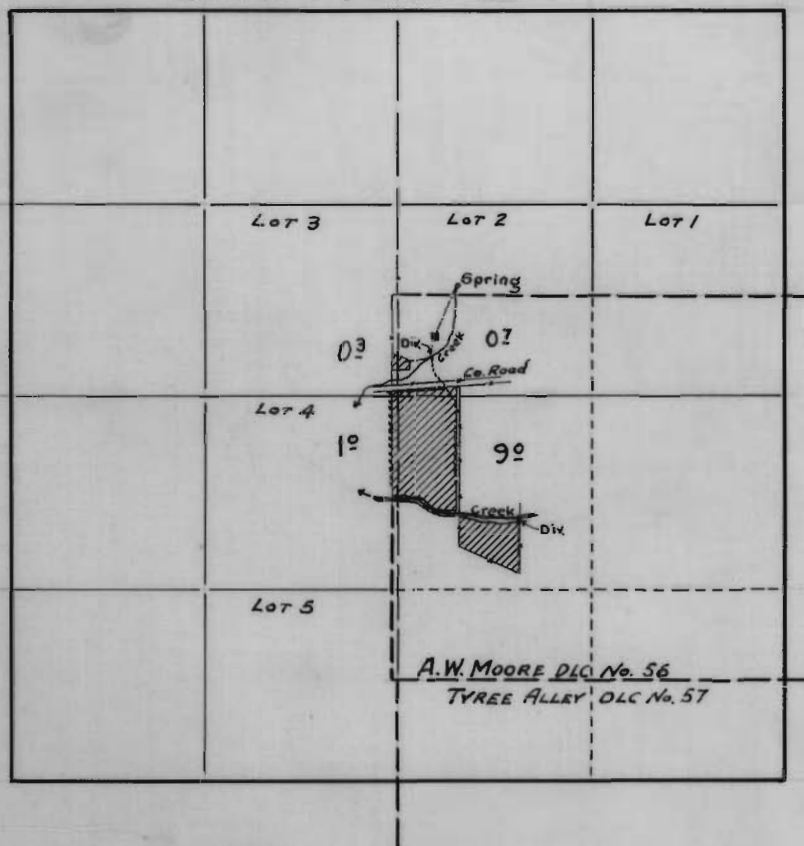

FINAL PROOF SURVEY
UNDER

Application No. 17850 Permit No. 13577

IN NAME OF

Guy N. Hutton

Surveyed Sept 4 1942, by Geo. Madernan