


T. 5 S., R. 1 E. W.M.

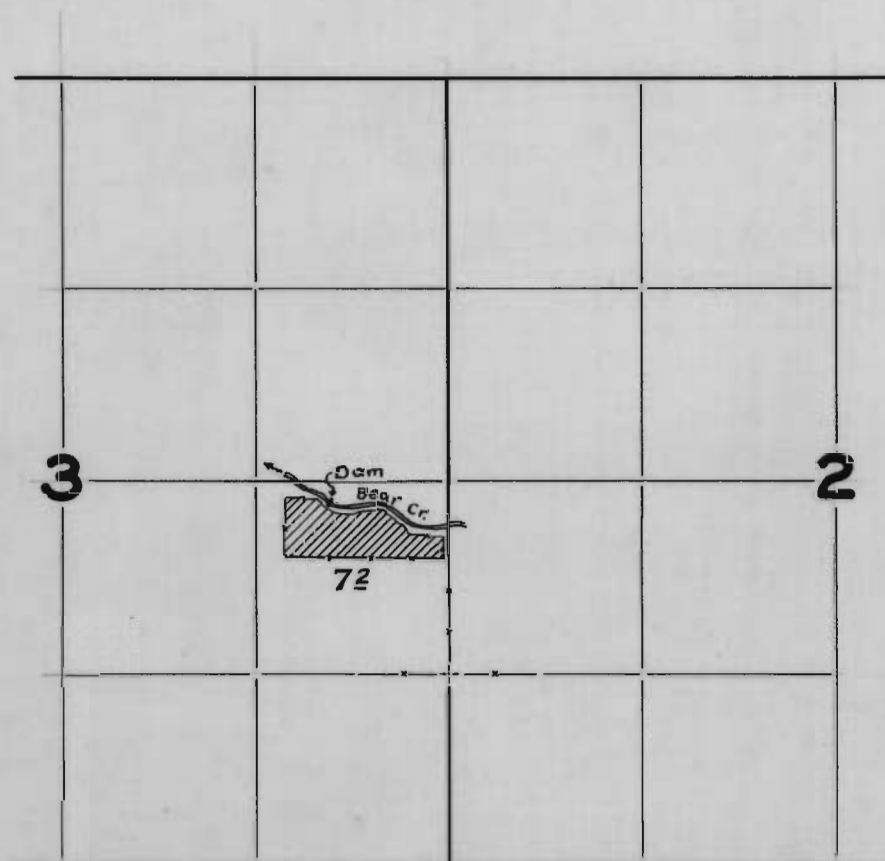

FINAL PROOF SURVEY

UNDER

Application No. 17947 Permit No. 13629

IN NAME OF

Albert F. Eyman

Surveyed July 22 1942, by Geo. W. Madarman