


T. 2 S., R. 4 W. W.M.

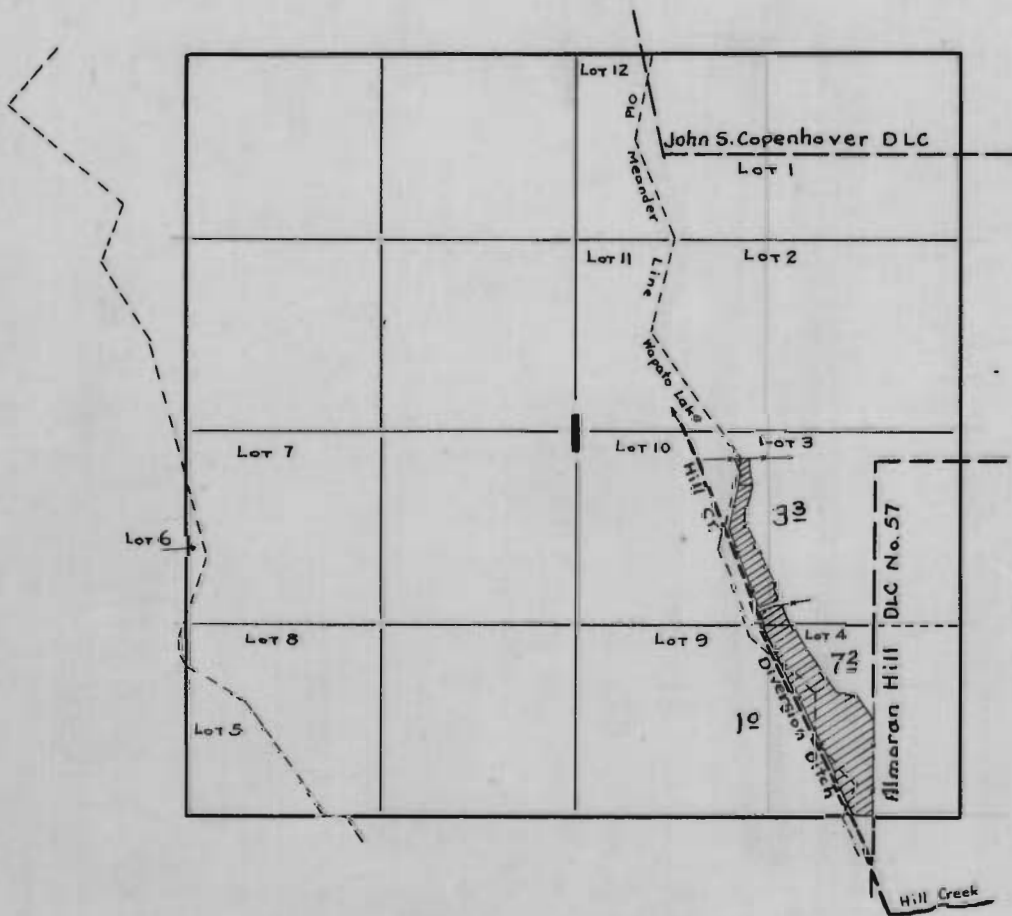

**FINAL PROOF SURVEY**  
UNDER

Application No. 17962 Permit No. 13640

IN NAME OF

William E. L. Brown

Surveyed Aug. 12 1942, by Paul Maderman