


T. 1 N., R. 3 W. W.M.

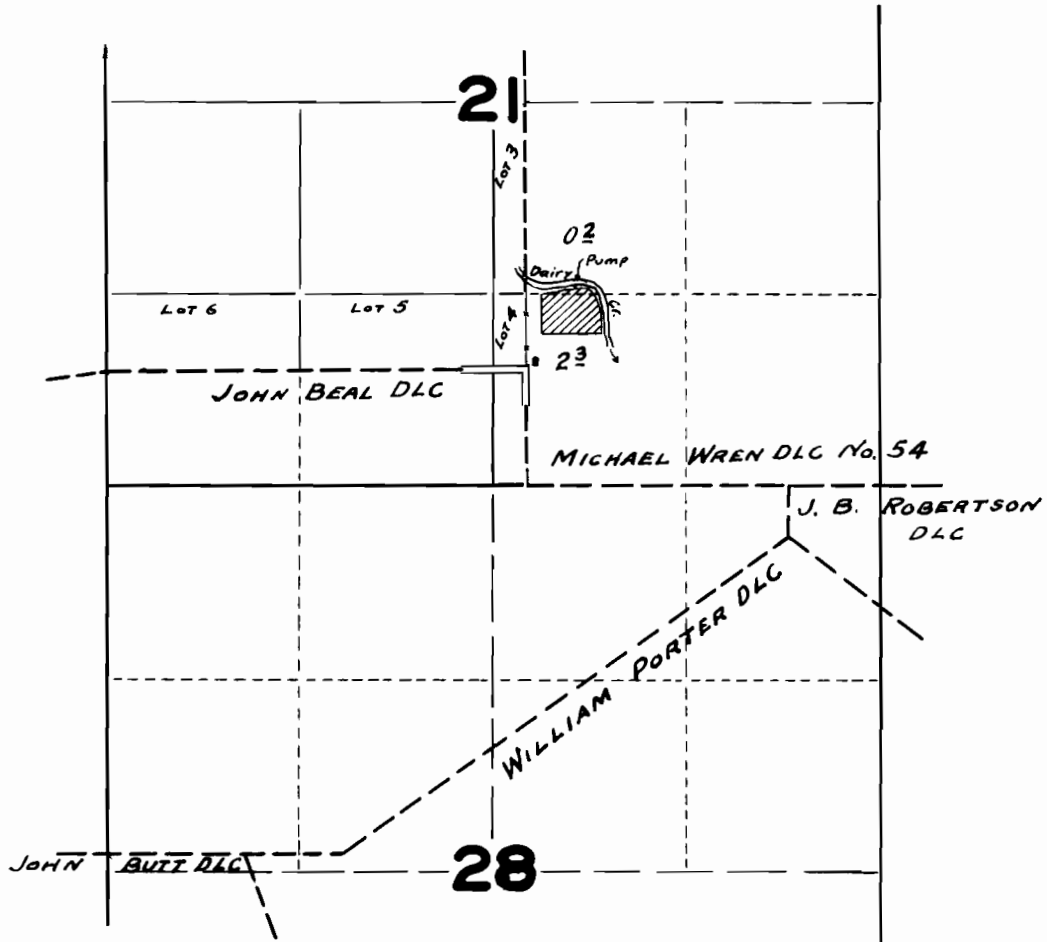

FINAL PROOF SURVEY UNDER

Application No. 17965 Permit No. 13642

IN FAVOR OF

R. E. Herman

Surveyed Aug. 10, 1942, by E. W. Madenman