


T. 3 S., R. 3 E. W.M.

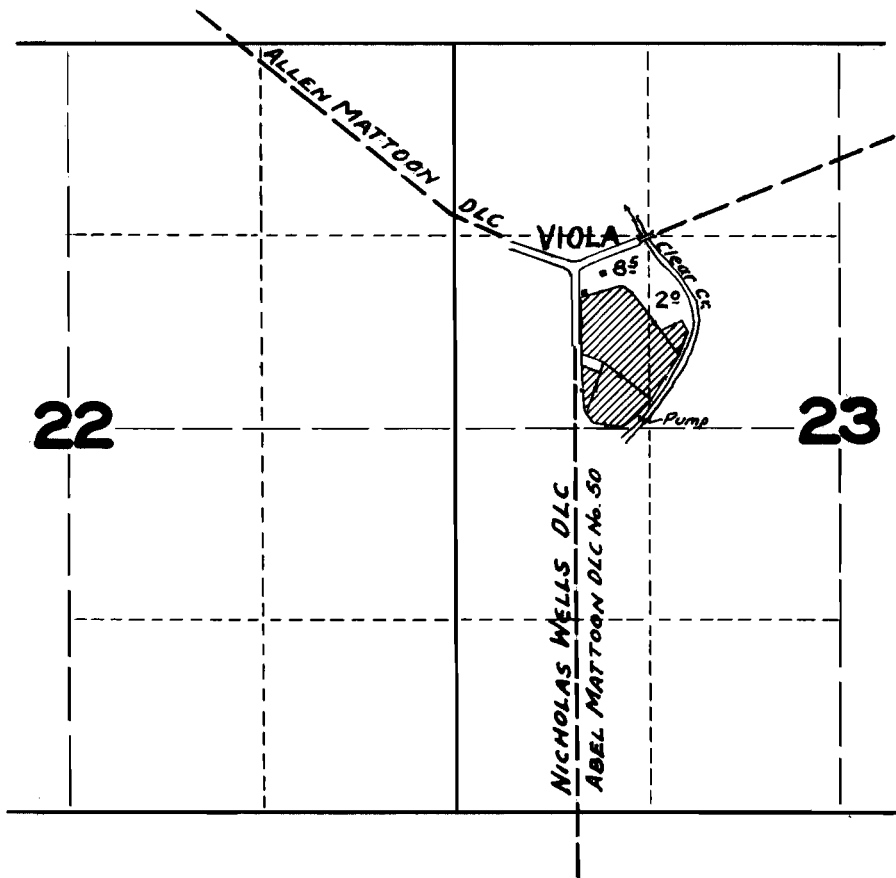

FINAL PROOF SURVEY
UNDER

Application No. 18020 Permit No. 13691

IN NAME OF

Carl M. Bennett

Surveyed July 27 1942, by Geo. W. Naderman