


# T. 3 S., R. 1 E. W.M.

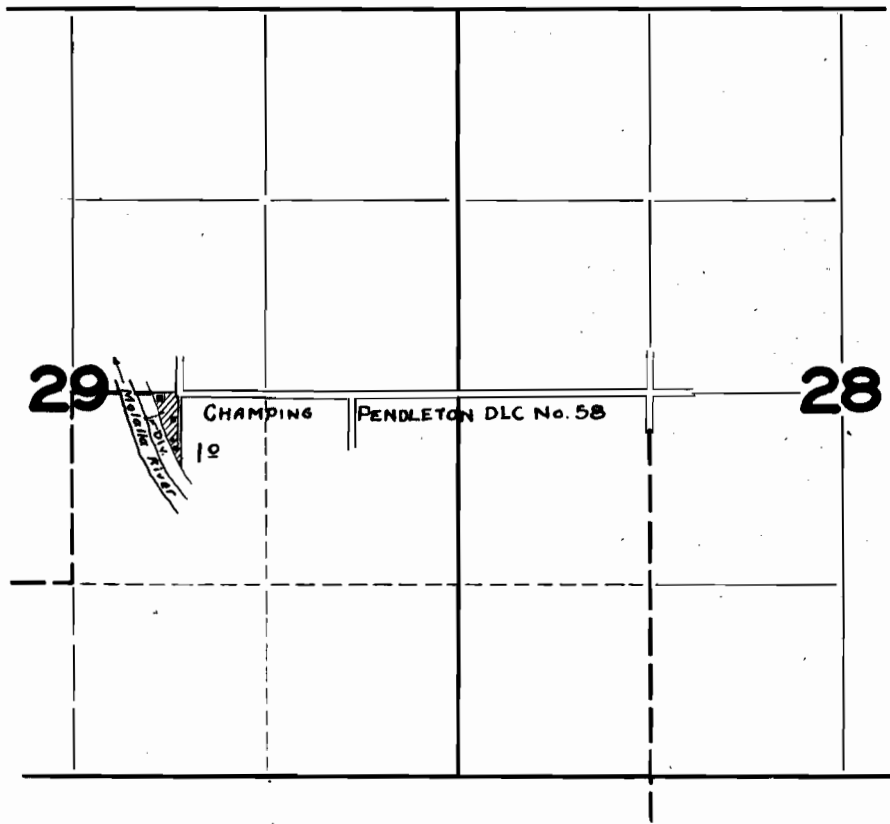

## FINAL PROOF SURVEY

UNDER

Application No. 18053 Permit No. 13721

IN NAME OF

H. M. Kleiser

Surveyed July 21, 1942, by Geo. W. Fiederman