


T. 3 S., R. 2 E. W.M.

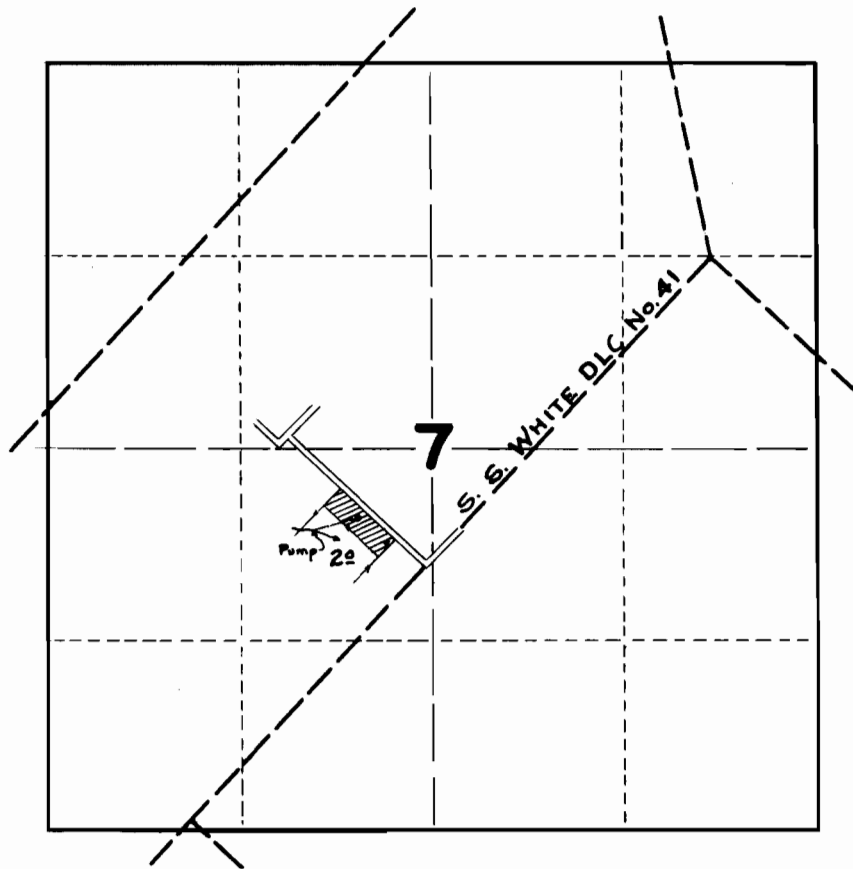

FINAL PROOF SURVEY UNDER

Application No. 18091 Permit No. 13751

IN FAVOR OF

W.D. & Anna Bishop

Surveyed July 27 1942, by Carl D. Maderman