


# T.12 S., R. 6 W. W.M.

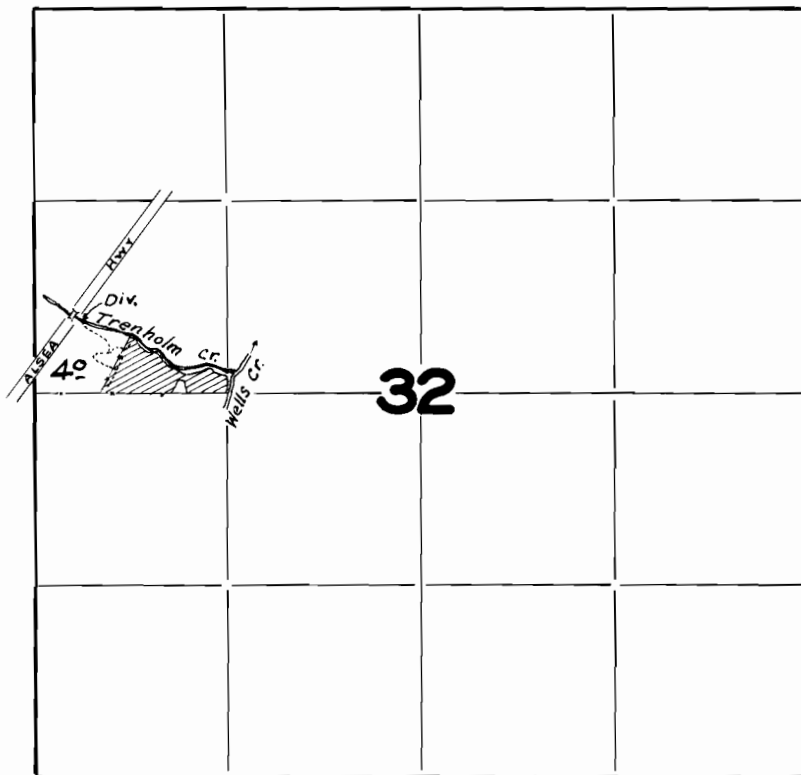

## FINAL PROOF SURVEY

UNDER

Application No. 18112 Permit No. 13765

IN FAVOR OF

Roy W. Wingo

Surveyed Sept. 2, 1942, by Geol. Naderman