


T. 8 S., R. 3 W. W.M.

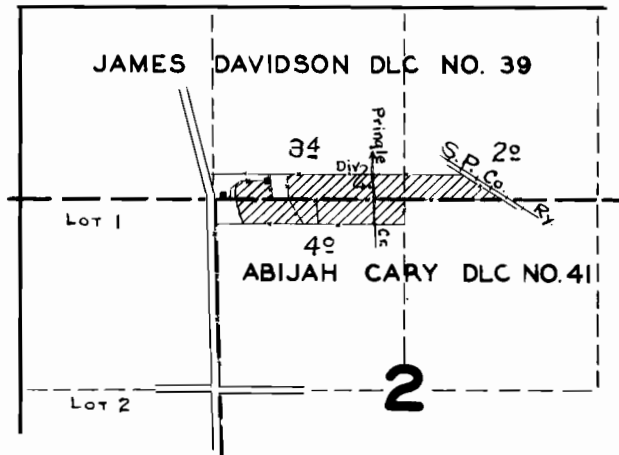

**FINAL PROOF SURVEY**

UNDER

Application No. 18122 Permit No. 13774

IN NAME OF

A. F. Bolton

Surveyed July 13, 1942, by Geo. Maderman