


T. 6 S., R. 6 W. W.M.

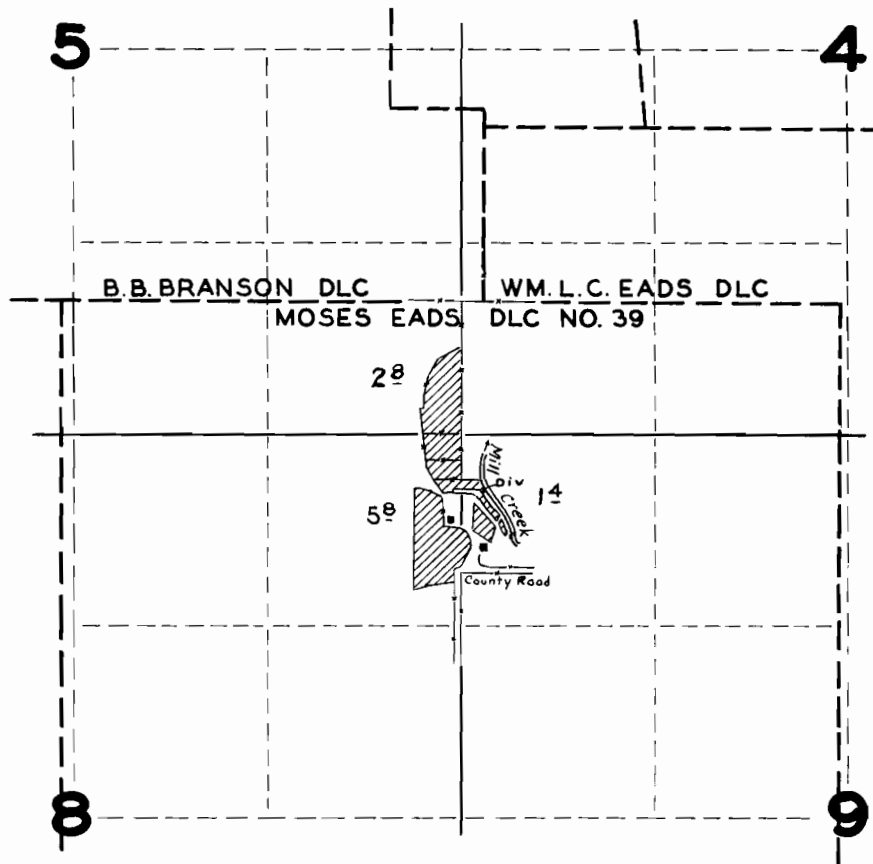

FINAL PROOF SURVEY UNDER

Application No. 18137 Permit No. 13782

IN NAME OF

W^m Rosenbalm

Surveyed June 12 1942, by Geo. W. Spederman