


# T. 1 N., R. 2 W. W.M.

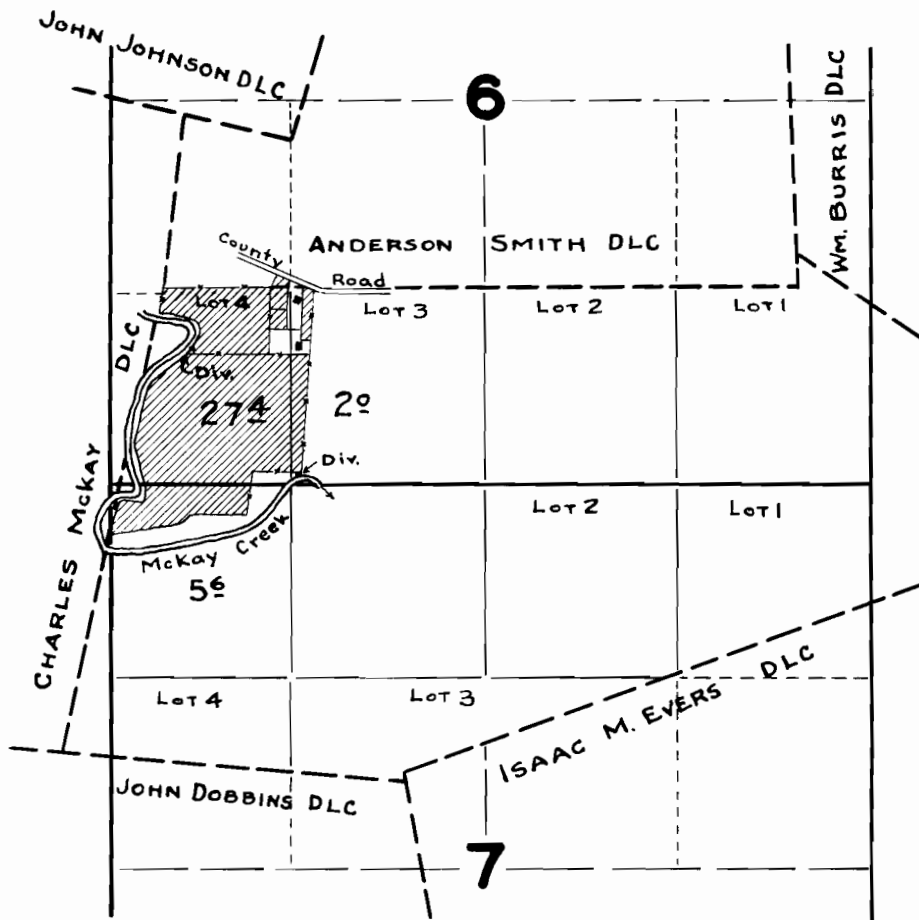

## FINAL PROOF SURVEY UNDER

Application No. 18140 Permit No. 13785

IN FAVOR OF

John A. Van Domelen

Surveyed Aug. 5 1942, by *Scott Maderman*