


TOWNSHIP 28 S., RANGE 11 W.

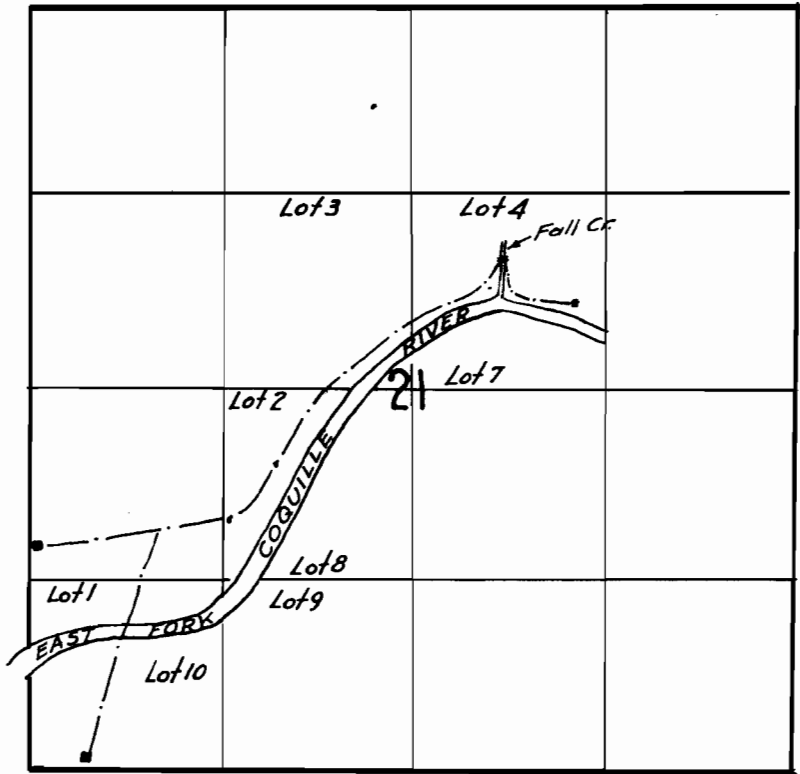

### FINAL PROOF SURVEY

UNDER

Application No. 18145 Permit No. 13789

IN NAME OF

A. J. Mayse

Surveyed June 14, 1941, by Ed Cummings