


9

TOWNSHIP 53S, RANGE 2E, W. M.

North

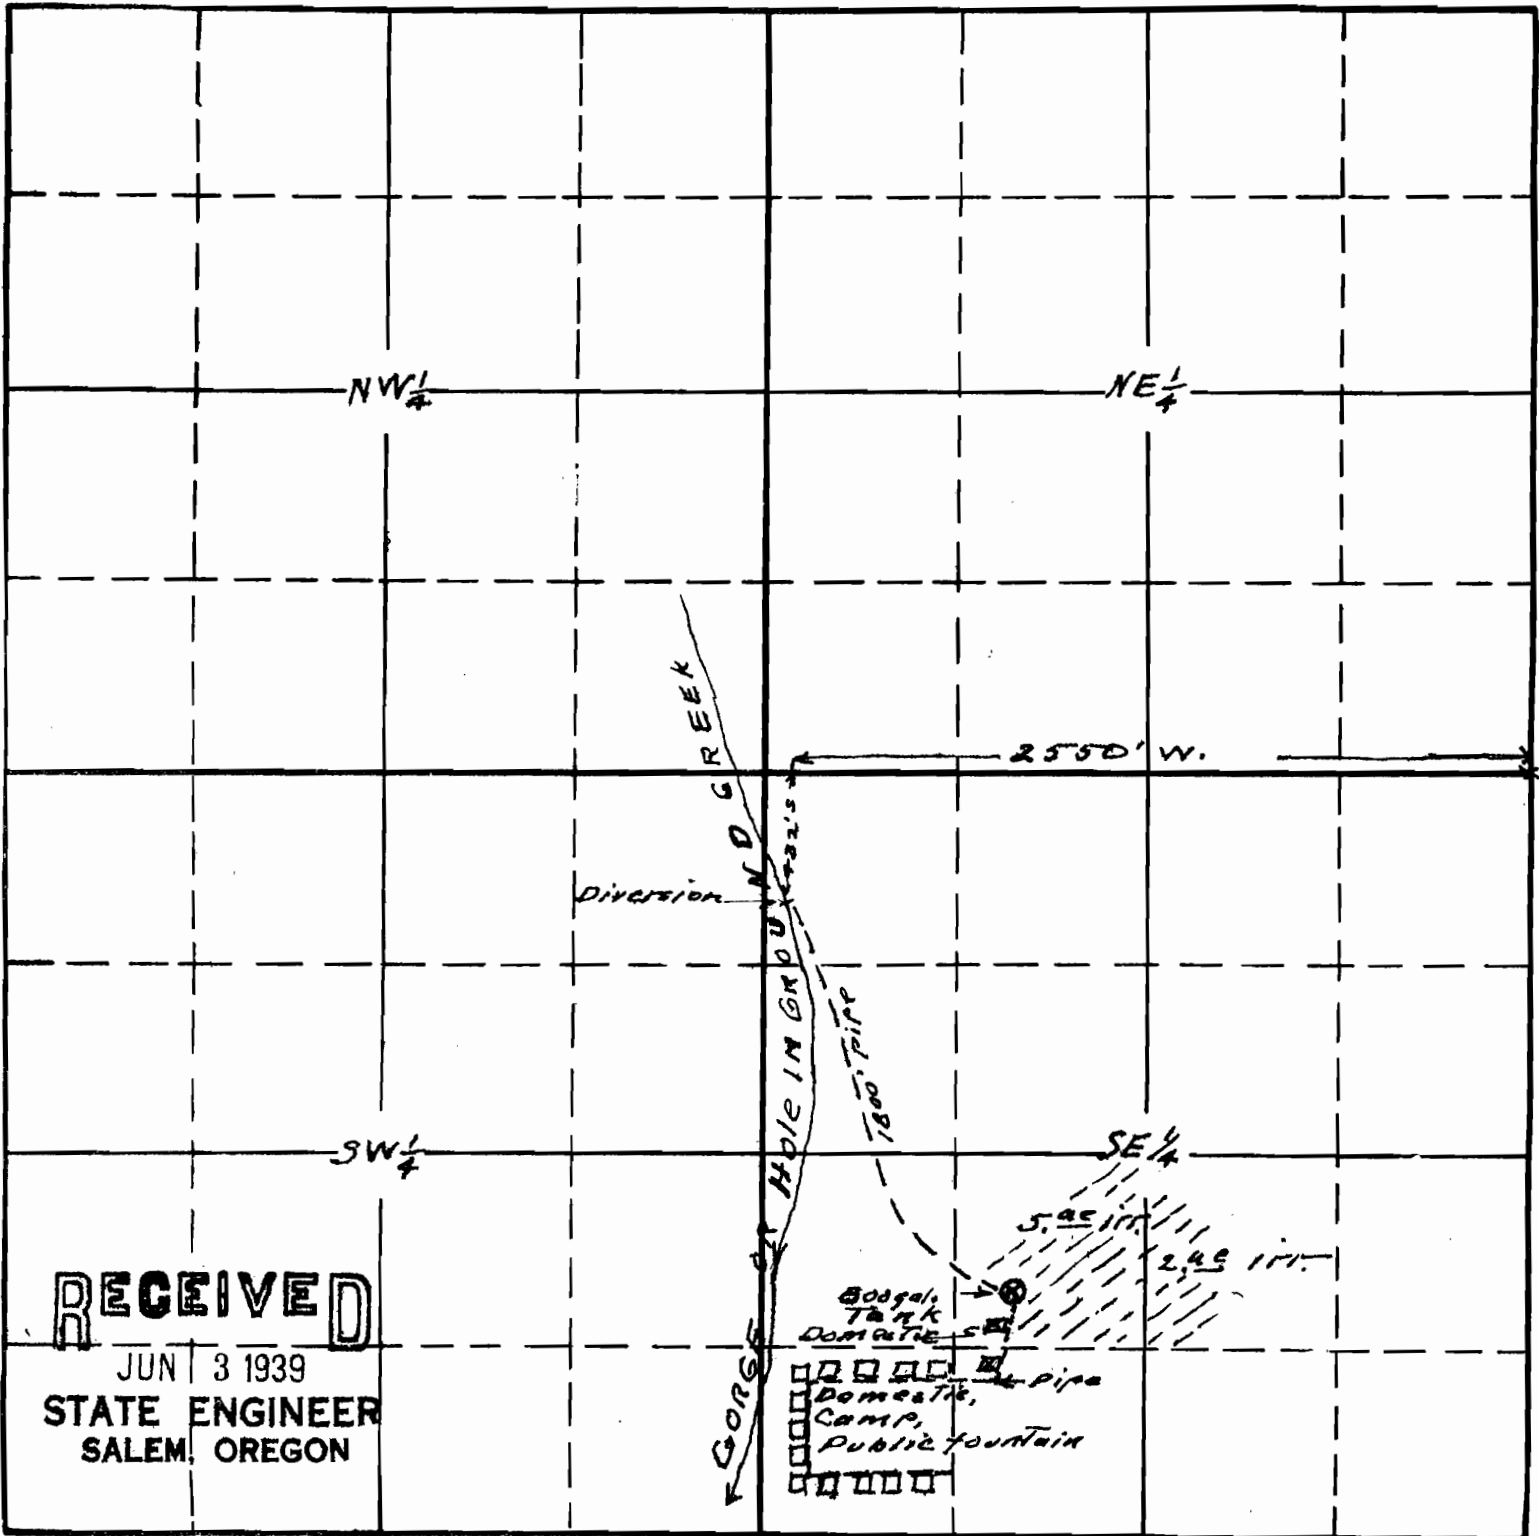

RECEIVED

JUN 3 1939

STATE ENGINEER
SALEM, OREGON

Sketch to accompany application of Joseph B and Christine E Dobbyn for use of waters of Gorge or Hole in Ground Creek for irrigation, domestic, public and camp ground use.

Measurements furnished by J.B.P.

18150 or 15-76
APPLICATION No. 18150
PERMIT No. 13794

This office 6/1/39