


T. 11 S., R. 6 W. W.M.

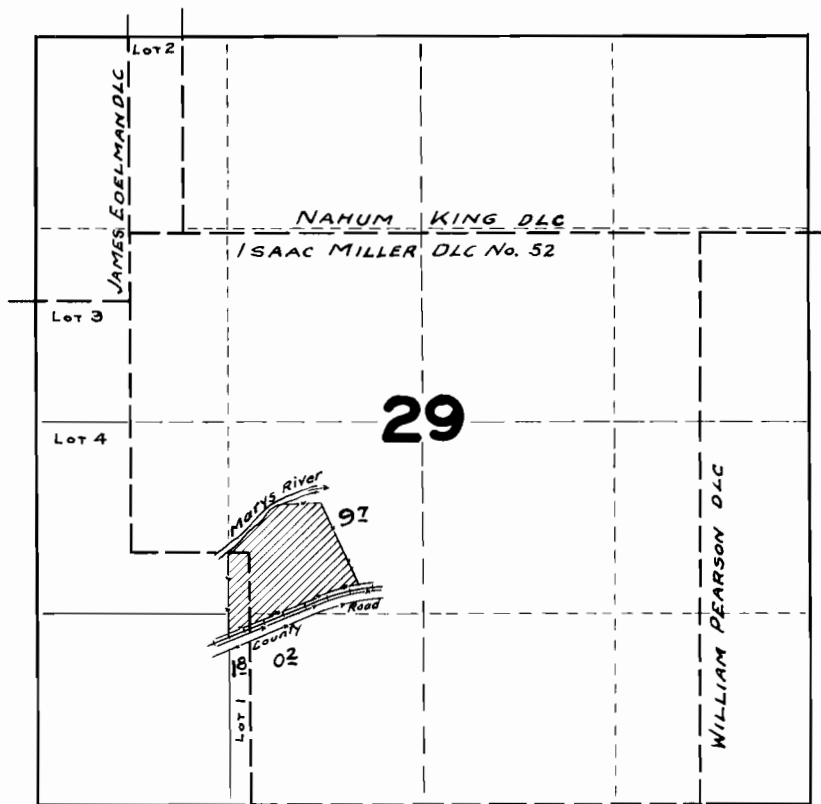

FINAL PROOF SURVEY UNDER

Application No. 18156 Permit No. 13798

IN NAME OF

A.C. Taylor

Surveyed Sept. 1, 1942, by Geo. W. Maderman