


T. I N., R. I W. W.M.

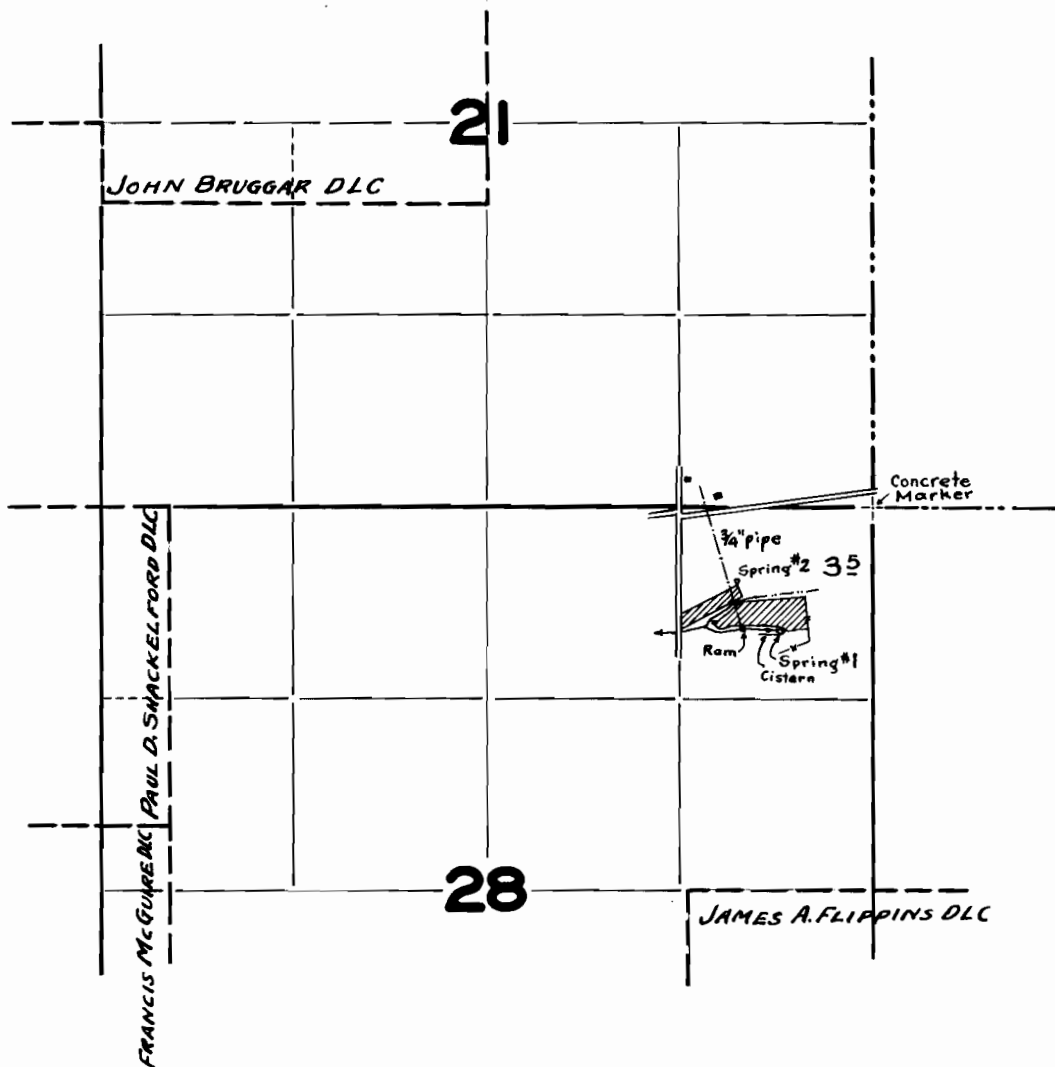

FINAL PROOF SURVEY UNDER

Application No. 18172 Permit No. 13807

IN FAVOR OF

Carl S. & Mary E. Hamel

Surveyed Aug. 5, 1942, by Geo. W. Maderman