


# T. 7 S..R. 2 W. W.M.

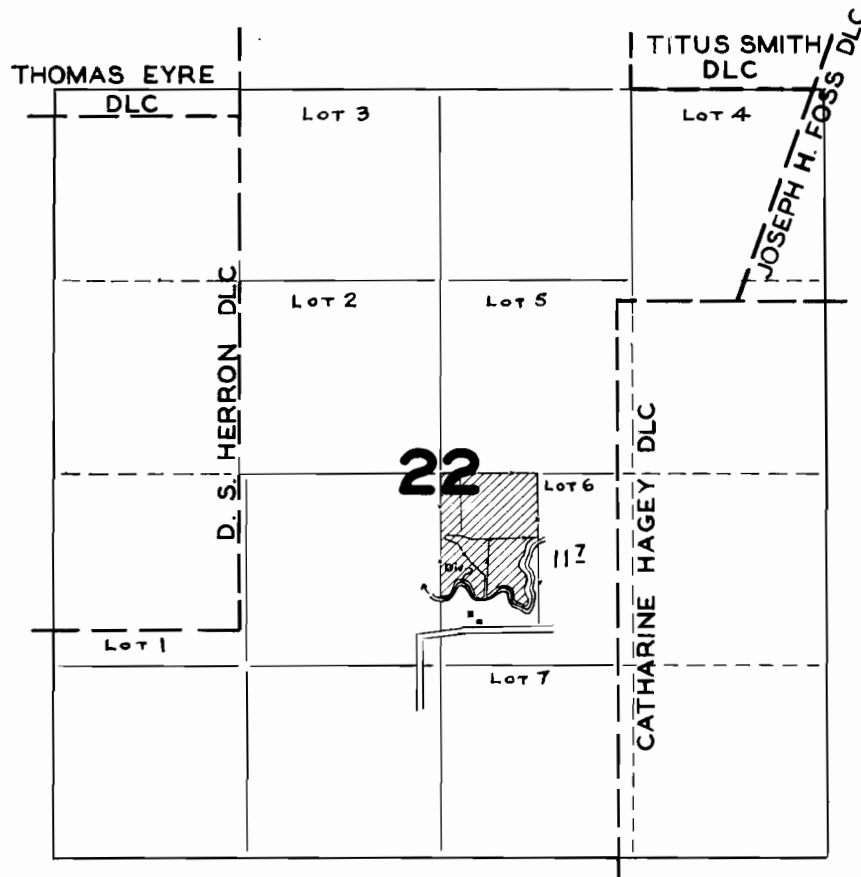

## FINAL PROOF SURVEY UNDER

Application No. 18188 Permit No. 13817

IN NAME OF

Fred E. Perin

Surveyed July 15 1942, by Geo. Maderman