


T. 2<sup>ND</sup> AND 3 S., R. 4 W. W.M.

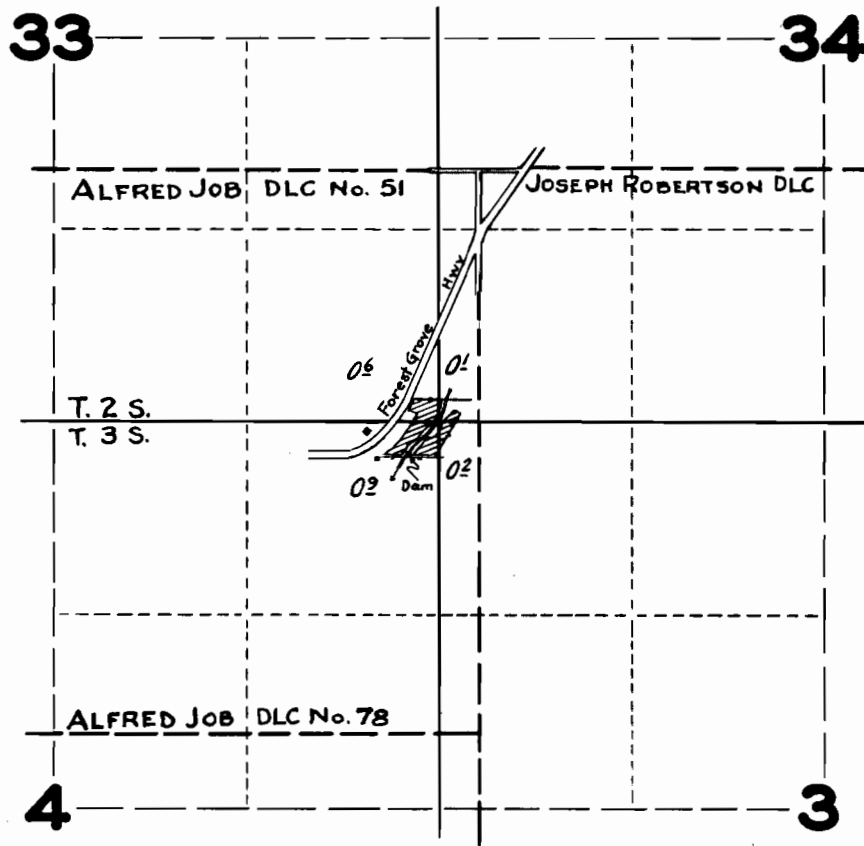

**FINAL PROOF SURVEY**  
UNDER

Application No. 18208 Permit No. 13832

IN NAME OF

W. C. Little

Surveyed Aug. 12, 1942, by Geoff Anderson