


T. 9 S.. R. 4 W. W.M.

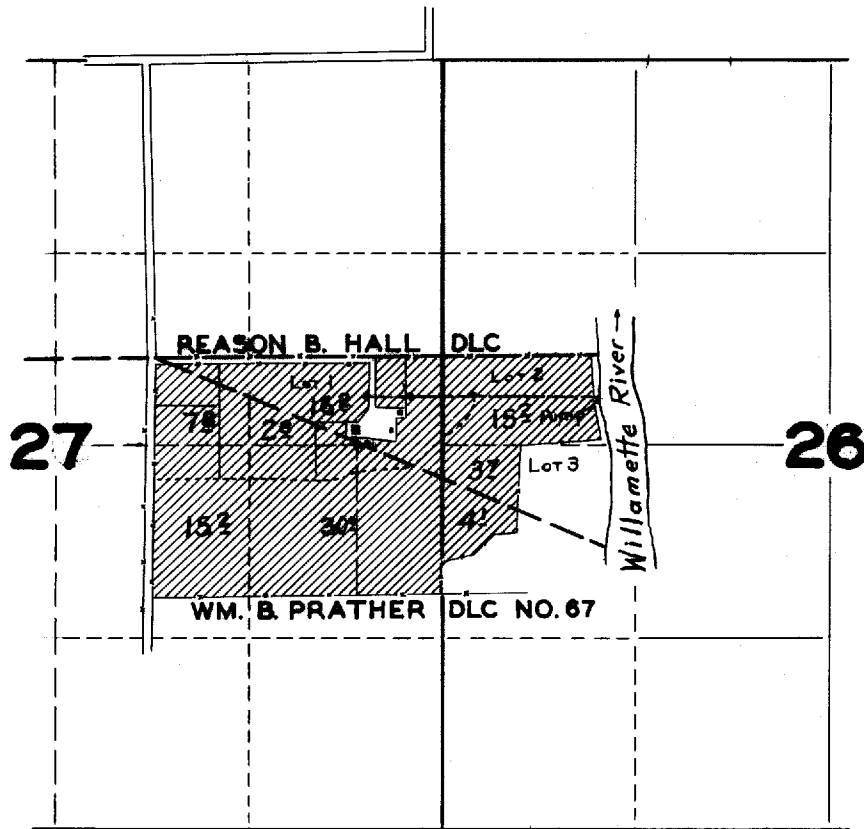

FINAL PROOF SURVEY
UNDER

Application No. 18212 Permit No. 13834
IN NAME OF

Nelson C. Anderson

Surveyed June 17, 1942, by Geoff Mademan