


T.12 S., R. 4 W. W.M.

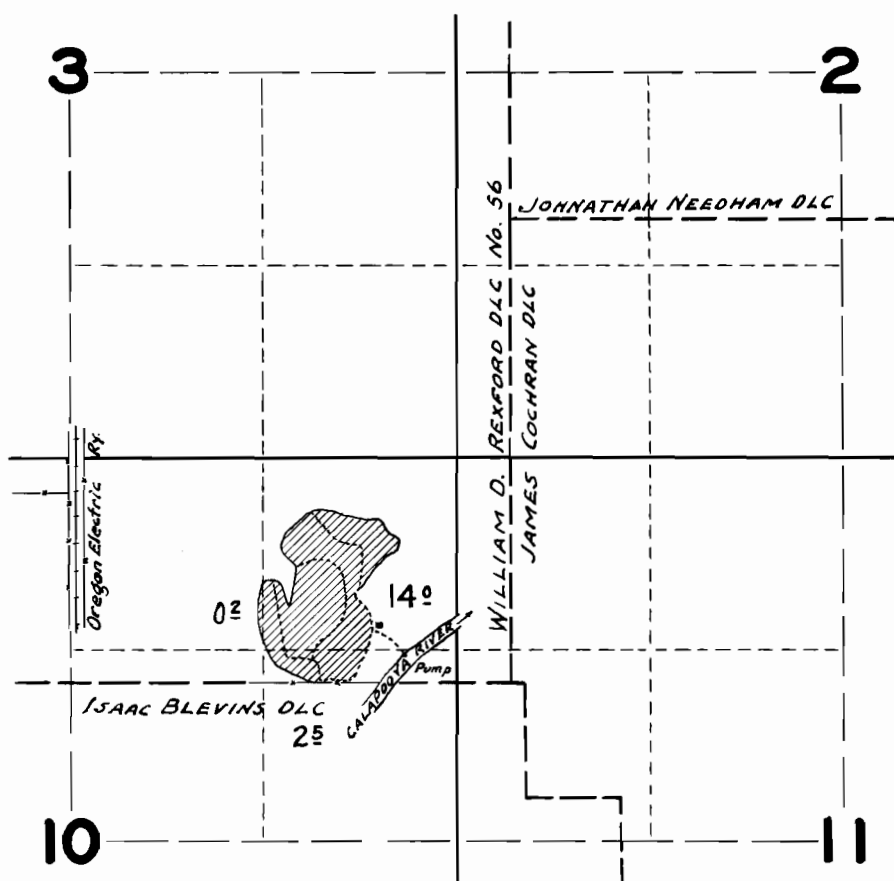

FINAL PROOF SURVEY

UNDER

Application No. 18221 Permit No. 13837

IN FAVOR OF

Benjamin A. Ohling

Surveyed Sept. 14, 1942, by *Geoff Naderman*