


T. 6 S., R. 1 W.W.M.

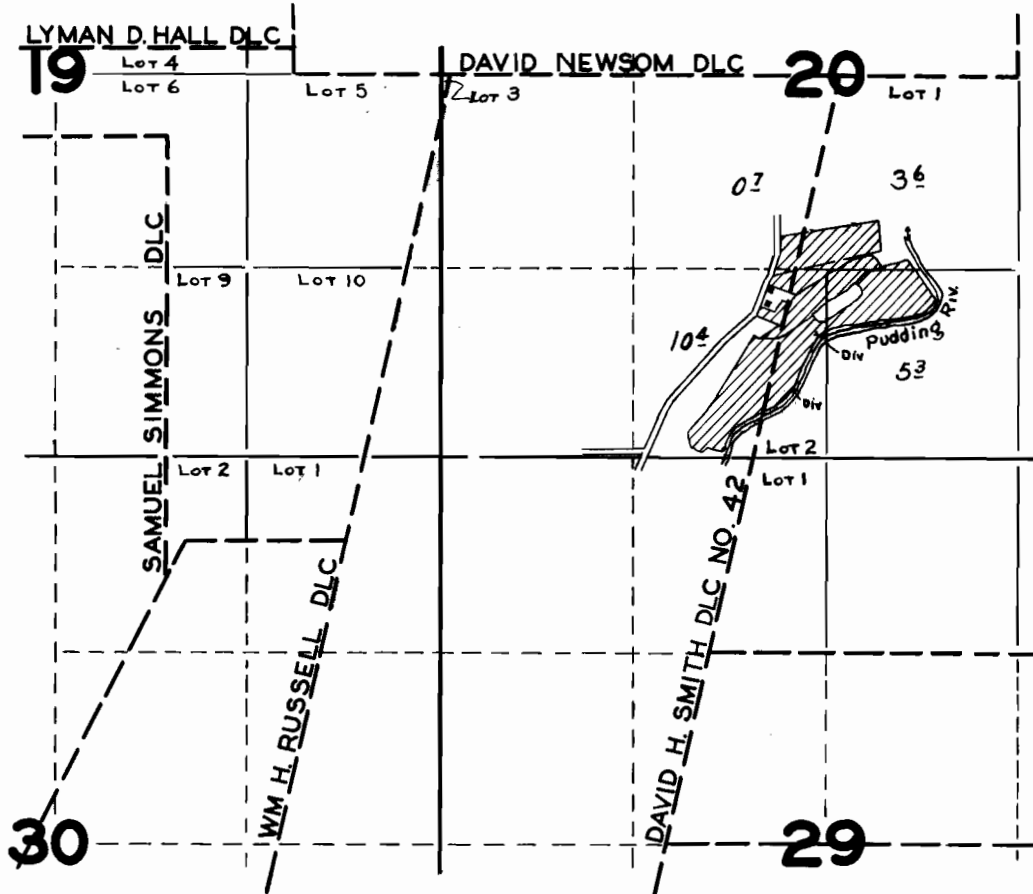

FINAL PROOF SURVEY UNDER

Application No. 18283 Permit No. 13931
IN NAME OF

E. G. Unger

Surveyed July 6, 1942, by Geo. Maderman