


T. 6 S..R. 8 W. W.M.

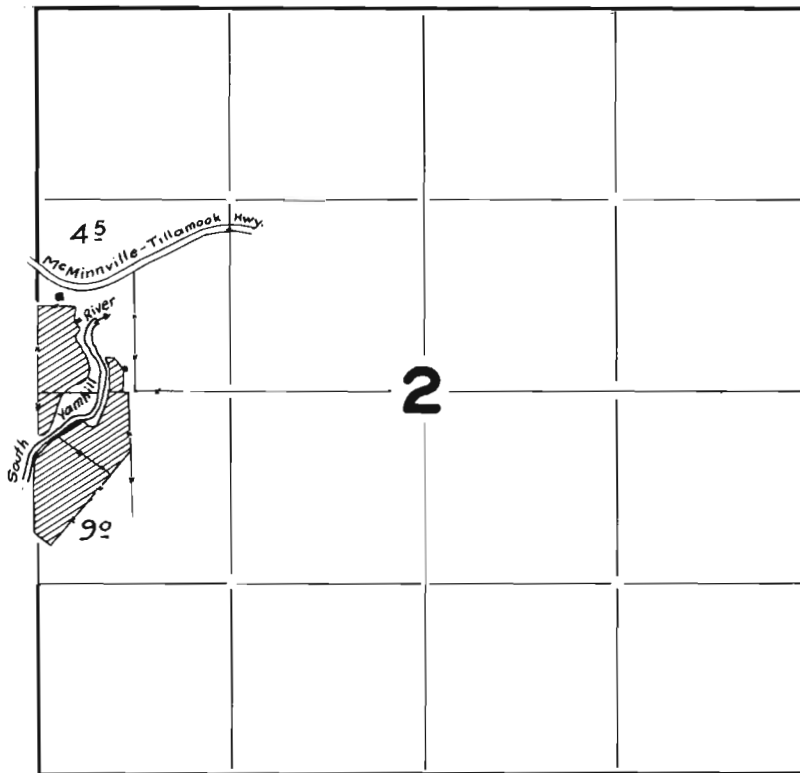

**FINAL PROOF SURVEY
UNDER**

Application No. 18328 Permit No. 13962

IN NAME OF

Myra Welch

Surveyed Aug. 14, 1942, by Geoff Spademan