


T. 1 S., R. 3 E. W.M.

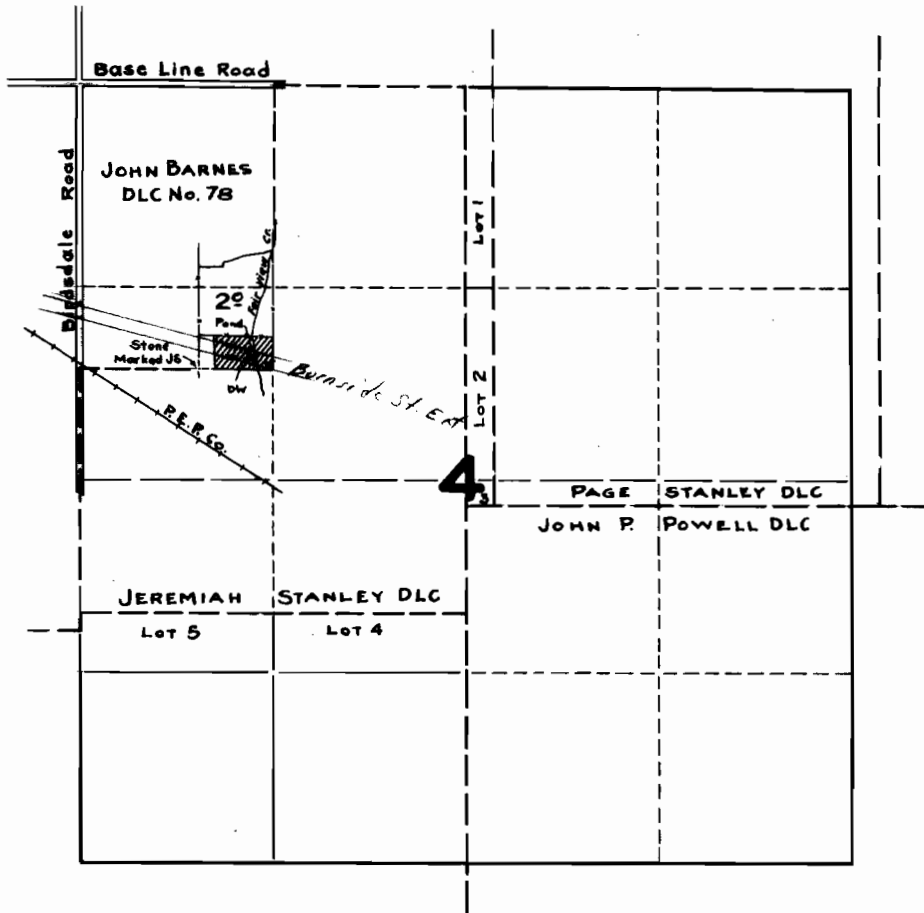

FINAL PROOF SURVEY UNDER

Application No. 18364 Permit No. 13987

IN FAVOR OF

N. Zenz

Surveyed July 29 1942, by Paul Jaderman