


# T. 1 N., R. 4 W. W.M.

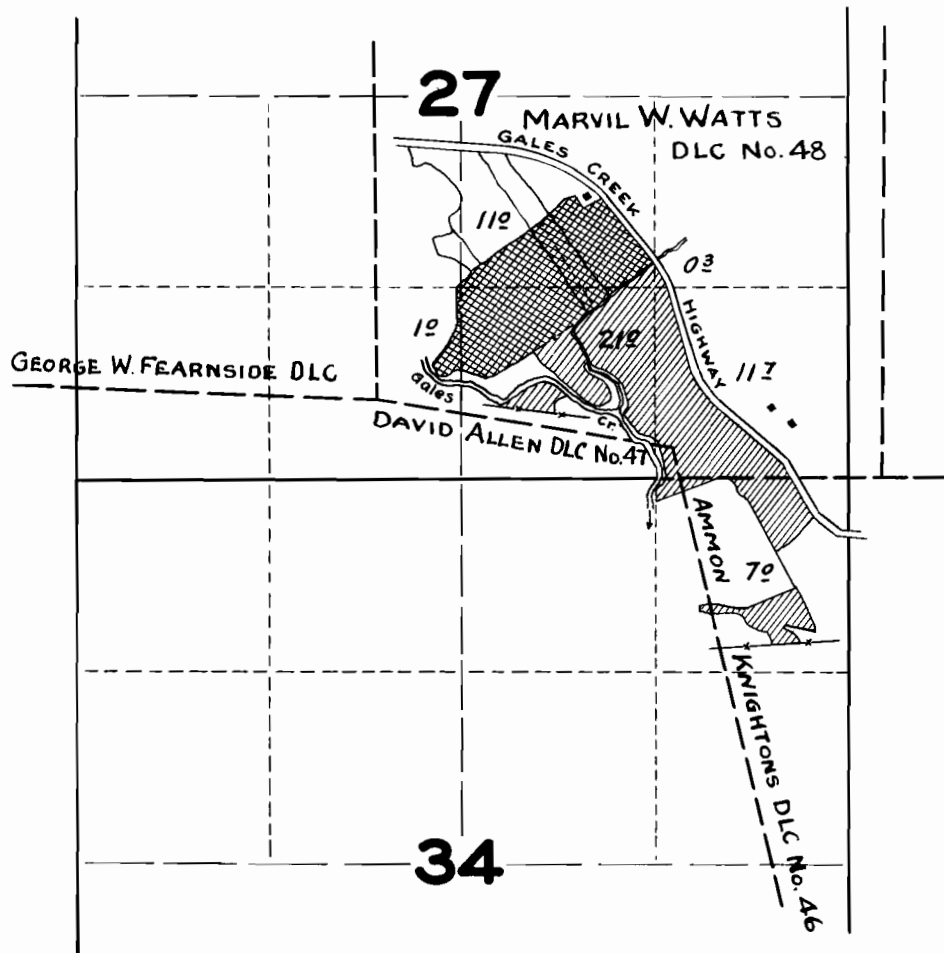

## FINAL PROOF SURVEY

UNDER

Application No. 17722 18605 Permit No. 13392 14246

IN FAVOR OF

Milton N. Simon

Surveyed Aug. 11, 1942, by Geol. Maderman