


# T. 7 S., R. 5 W. W.M.

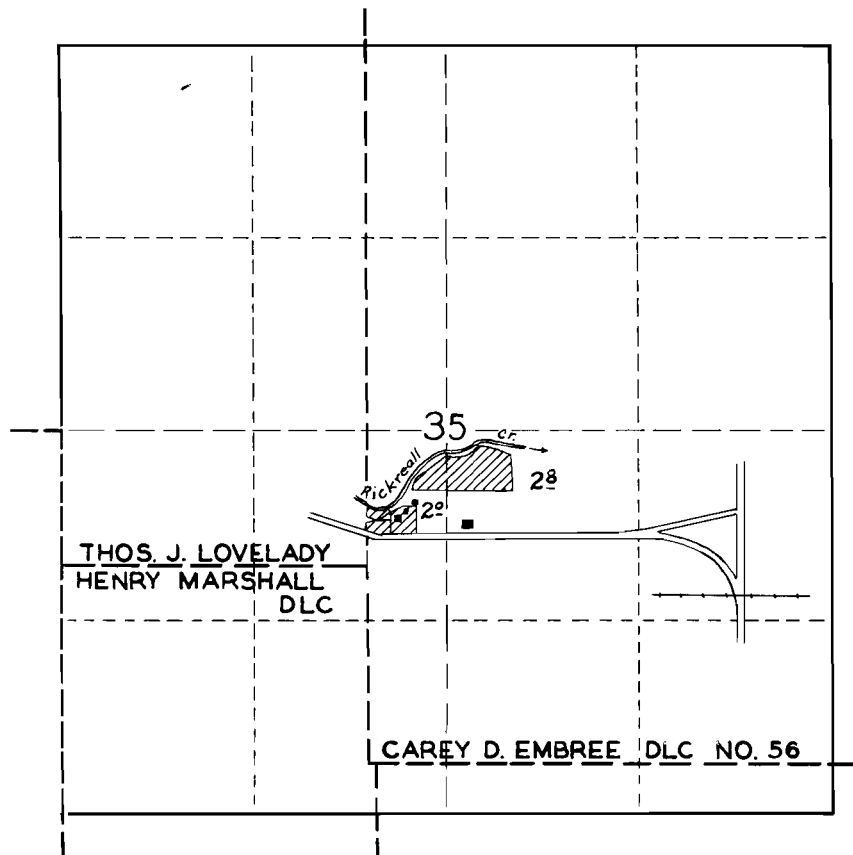

## FINAL PROOF SURVEY

UNDER

Application No. 18612 Permit No. 14250

IN NAME OF

George Minty

Surveyed June 10 1942, by Geo. Naderman