


# T. 1 N., R. 2 W. W.M.

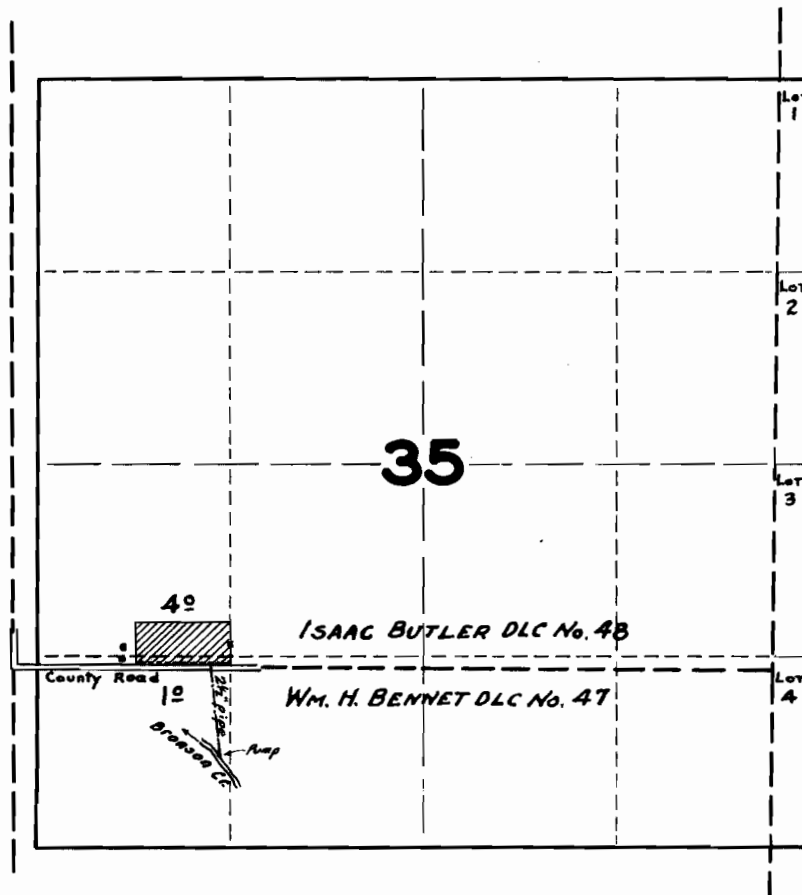

## FINAL PROOF SURVEY UNDER

Application No. 18670 Permit No. 14301

IN FAVOR OF

F. J. Meihoff

Surveyed Aug. 5, 1942, by Geo. W. Naderman