


# T. 5 S., R. 1 W. W.M.

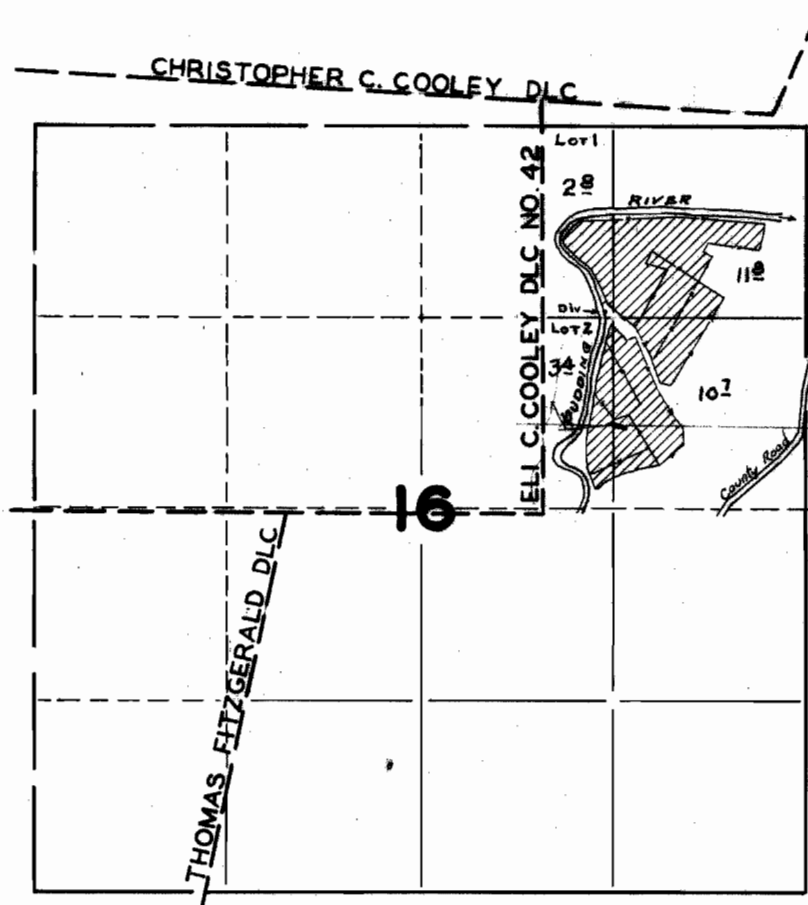

## FINAL PROOF SURVEY UNDER

Application No. 18755 Permit No. 14360

IN NAME OF

A. L. Harader

Surveyed July 1, 1942, by Scott Pederman