


T.12 S., R. 1 E. W.M.

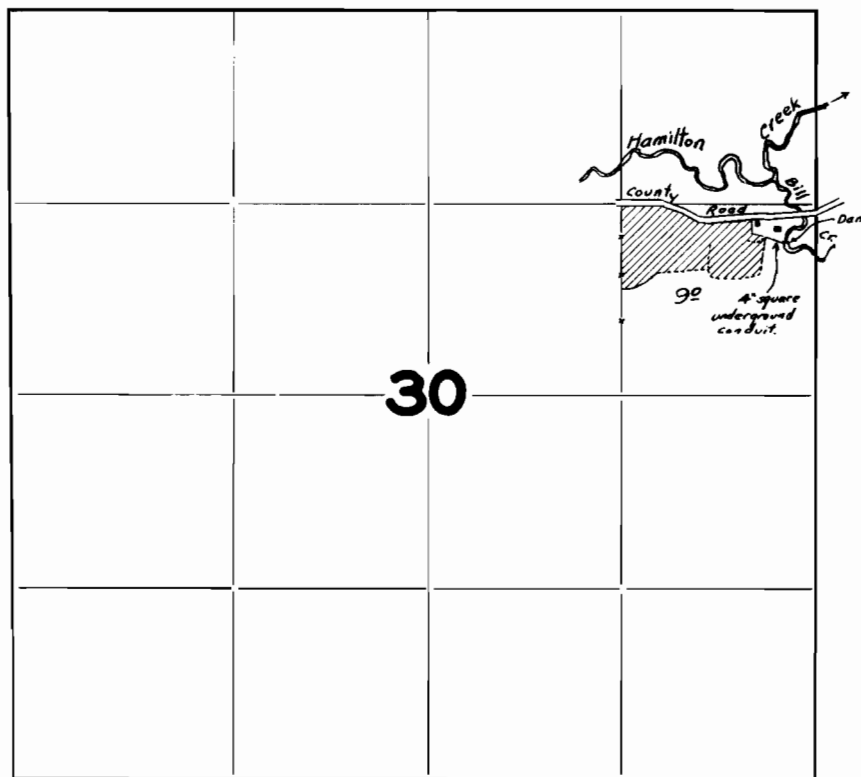

FINAL PROOF SURVEY

UNDER

Application No. 18885 Permit No. 14389

IN FAVOR OF

Ed Thomas

Surveyed Sept 14 1942, by Geo. Maderman