


T. 7 S., R. 11 W. W.M.

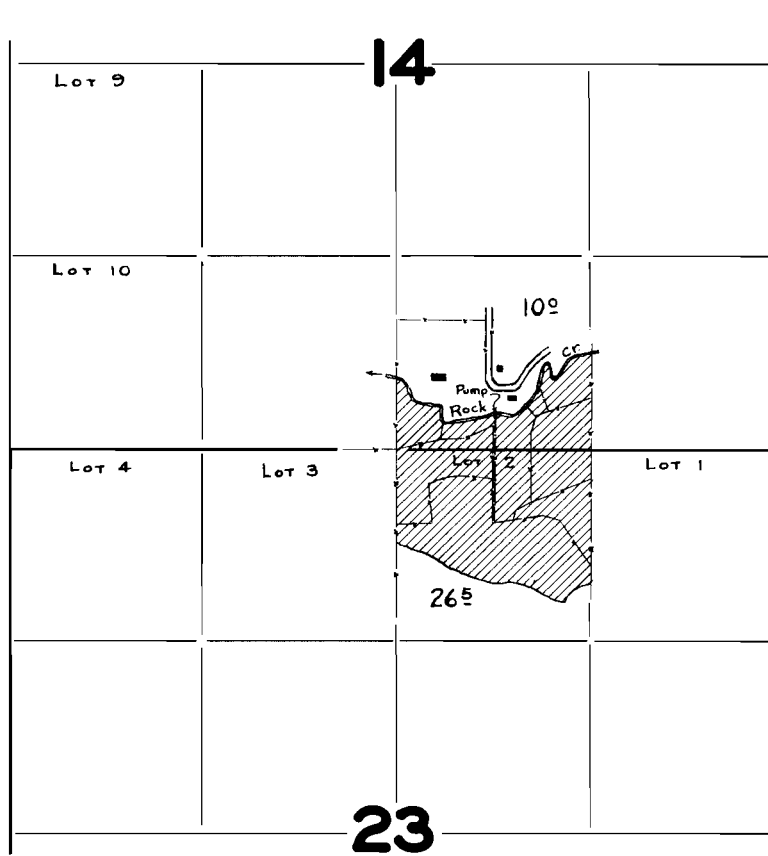

FINAL PROOF SURVEY UNDER

Application No. 18827 Permit No. 14465

IN NAME OF

Howard McMillen

Surveyed Sept. 10, 1942, by Geo. J. Aderman