


# T. 12 S., R. 6 W. W.M.

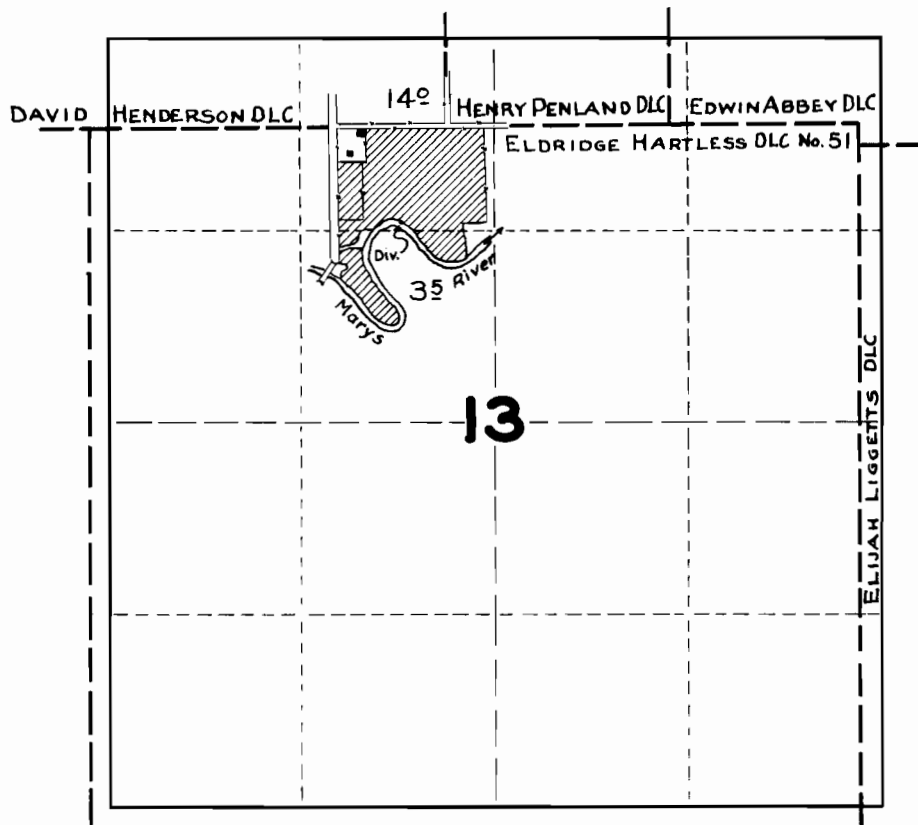

## FINAL PROOF SURVEY UNDER

Application No. 18893 Permit No. 14508

IN NAME OF

Carl H. Haight

Surveyed Sept. 2, 1942, by Geoff Maderman